


# U.S. PUBLIC LAND SURVEY MONUMENT RECORD

**Note:** This form is intended and designed to fulfill all requirements of Wisconsin Administrative Code, Chapter A-E 7.08 U.S. Public Land Survey Monument Record (3) (a) (b) (c) (d) (e) (f) (g) (h) (i). An additional sheet may be added if necessary to conform with said requirements.

**(a) Corner location:** Township 36 North  
 Range 7 East/West  
 Town/City/Village Woodboro  
 County Oneida.

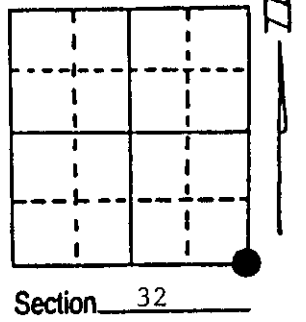


**(b) (f) (g) (h) Description of monument found at this corner and if it was accepted, state all evidence (material, testimonial, occupational, plats, records, other monuments) used as a basis for accepting. If not accepted or if nothing was found, state evidence used as basis for establishing location. If reestablished through lost corner proportionate methods, indicate all monuments, distances and directions used to establish. Indicate type of monument found or set and sign post.**

- 8/30/1860 - Alfred Millard established this corner and set a wood post with four BTs:  
 9" Aspen, N87°E, 104 Links                      24" W. Pine, S37°W, 28 Links  
 9" Aspen, S5°E, 45 Links                      24" Y. Pine, N54°W, 43 Links
- 10/22/49 - Wincentsen found iron pipe with iron marks plain on southwest BT and northwest BT rotted out. He made two new BTs:  
 8" Oak, S55°W, 10 Links                      6" Oak, N34°E, 10 Links
- 1966 - Owen - Illinois was here and placed a cedar post next to iron pipe.
- 7/26/89 - Milo E. Stefan found 3/4" x 5' iron pipe along side scribed cedar post. Remains of northwest and southwest original BTs in place. We restored corner by placement of an aluminum monument and made new BTs.

**(c) (d) (e) Plan view of corner with ties to at least 4 witness monuments. If in disagreement with previously established corner, show the distances between the two corners and also indicate the ties to the disputed corner.**

- 1) 2" x 30" aluminum Oneida County Monument with 3/4" iron pipe along side.
- \*2) 8" Red Oak, N34°E, 7.04'
- \*\*3) 12" Red Oak, S83°E, 25.89'
- \*4) 10" Red Oak, S55°W, 6.86'
- \*\*5) 6" Red Oak, N18°W, 10.73'
- 6) Plastic sign post, North, .7'

\*Old BTs not rescribed, faces overgrown.  
 \*\*New BTs, scribed "BT" in stump blaze.  
 Distances to nail in side of BTs.

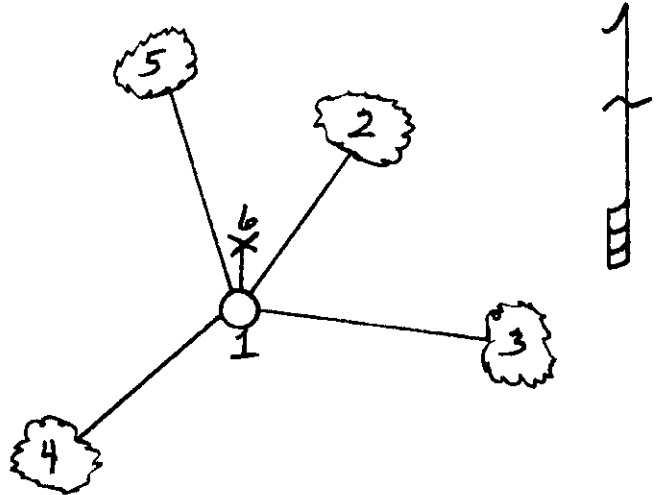

(i) I, Milo E. Stefan  
 (type or print name) certify that the corner location on this record was determined by me or under my direction and control and that this U.S. Public Land Survey Monument Record is correct and complete to the best of my knowledge and belief.

Milo E. Stefan                                      8/5/89  
 Signature    Date



3607320000