


U. S. PUBLIC LAND SURVEY MONUMENT RECORD

Note: This form is intended and designed to fulfill all requirements of Wisconsin Administrative Code—Chapter A-E 7.08 U. S. Public Land Survey Monument Record (3)(a)(b)(c)(d)(e)(f)(g)(h)(i). An additional sheet may be added if necessary to conform with said requirements.

(a) CORNER LOCATION: State Plane Coordinates
Meander corner of Sec. 32 X ---
 Township 36 North Y ---
 Range 7 East Datum Base ---
 Town Woodboro County of Oneida

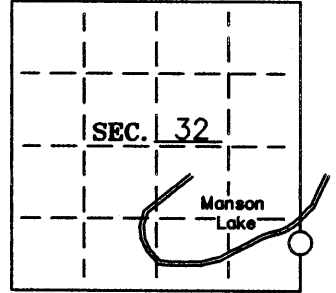

(b) HISTORY OF ORIGINAL CORNER ESTABLISHMENT:
 Original Surveyor: Joseph H. Jenkins
 Date of Survey: Commenced 1862
 Completed 1862

Original B.T.'S


10" Birch, S61°W, 30 lks
 12" Birch, S86°E, 28 lks

(b)(f)(g)(h) Description of monument found at this corner and if it was accepted—state all evidence (material—testimonial—occupation—plats—records—other monuments) used as a basis for accepting. If not accepted or if nothing was found state evidence used as basis for establishing location. If reestablished through lost corner proportionate methods indicate all monuments—distances and directions used to establish. Indicate type of monument and sign post found or set.


- 1949— F.R. Wincentsen set an iron pipe near the south shore of Manson Lake for the Meander Corner on the east line of Section 32 while surveying Gov't. Lots 6 & 7, Section 32, and Gov't Lot 4, Section 33. Bearing trees on 1949 survey map: 6" Oak, N85°W, 5.0'; and 5" W. Birch, N34°E, 11.2'. Bearing trees on 1949 field notes: 6" Hemlock, S3°E, 6 lks; and 7" W. Birch, S52°E, 19.5 lks.
- 1974— Genisot & Associates, Inc. found and accepted an iron pipe at the Meander Corner location.
- 2007— We found and accepted a 2" iron pipe for the Meander Corner on the south shore of Manson Lake and replaced it with an Oneida County Aluminum Monument. Witnesses for the Meander Corner are shown below.

(c)(d)(e) Plan view of corner with ties to at least 4 witness monuments. If in disagreement with previously established corner—show the distances between the two corners and also indicate the ties to the disputed corner—

REGISTER OF DEEDS OFFICE
 ONEIDA COUNTY, WIS.

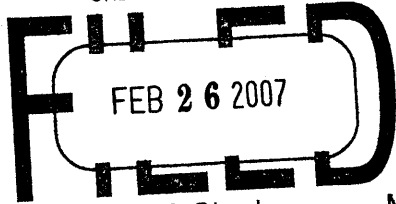


At O'Clock M
THOMAS H. LEIGHTON Birch
 REGISTER OF DEEDS (Existing—Dead)

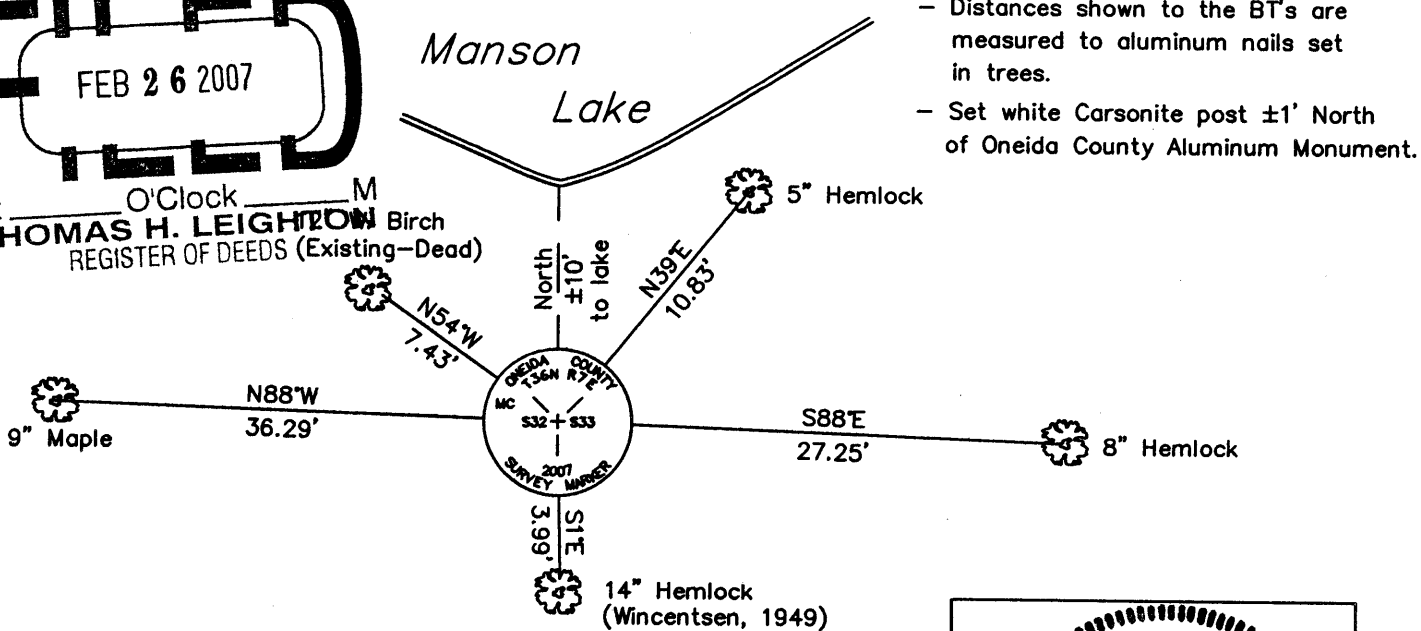

- Distances shown to the BT's are measured to aluminum nails set in trees.
- Set white Carsonite post ±1' North of Oneida County Aluminum Monument.

(i) I Stuart L. Foltz S-1170
 hereby certify that the corner location on this record was determined by me or under my direction and control and that this U.S. Public Land Survey Monument Record is correct and complete to the best of my knowledge and belief.

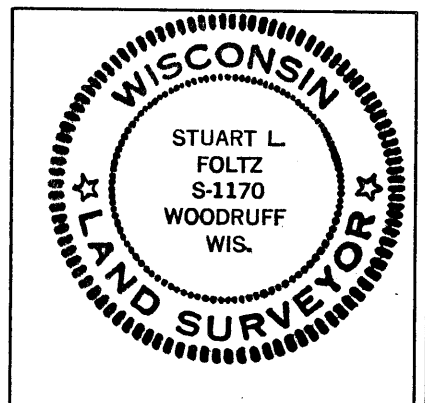

INDEX NO. 7-29

Signature Stuart L. Foltz Foltz and Associates, Inc. Date 2/21/2007


36073206 00

U.S. PUBLIC LAND SURVEY MONUMENT RECORD

Note: This form is intended and designed to fulfill all requirements of Wisconsin Administrative Code, Chapter A-E 7.08 U.S. Public Land Survey Monument Record (3)(a-i).

(a) CORNER LOCATION
 Meander Cor. of Secs. 32 & 33
 Township 36 North
 Range 7 East of the 4th P.M.
 Town of Woodboro
 County of Oneida

WISCORS - Oneida County
 N: 135,749.32 USft
 E: 207,812.24 USft
 Datum: NAD 83(2011) ep. 2010.00
 GNSS Method: RTN - Offset
 GNSS Control: WISCORS VRS

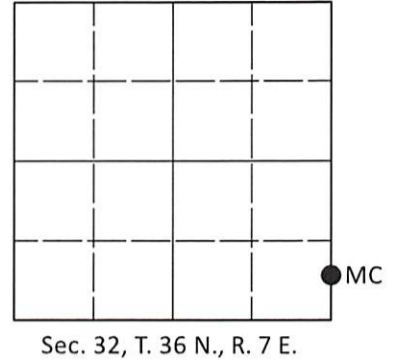

(b)(f)(g)(h) Description of monument found at this corner and if it was accepted, state all evidence (material, testimonial, occupational, plats, records, other monuments) used as a basis for accepting. If not accepted or if nothing was found, state evidence used as basis for establishing location. If re-established through lost corner proportionate methods, indicate all monuments, distances and directions used to establish. Indicate type of monument and sign post found or set.

This record is a perpetuation of the following land corner document(s):


February 21, 2007: USPLS Monument Record by Stuart L. Foltz, filed in Oneida County

A complete history of the corner can be found on the previous land corner document(s). I accept the record activity as a true and faithful perpetuation or reestablishment of the original corner location and further perpetuate it as described below.

April 10, 2022: I found and accepted the record monument, a 2.4" diam. aluminum pipe, firmly set, with a 3.3" diam. Oneida Co. aluminum cap projecting 4" above the ground surface. I found or established accessories as indicated below. I found a white vinyl sign post bearing North, 1.4 ft.

The coordinate value shown has been determined by traversing from two or more GNSS offset points satisfying the accuracy requirements defined and qualified in the 2022 Oneida County Fee Schedule for USPLS Corners.

(c)(d)(e) Plan view of corner with ties to at least 4 witness monuments. If in disagreement with previously established corner, show the distances between the two corners and also indicate the ties to the disputed.

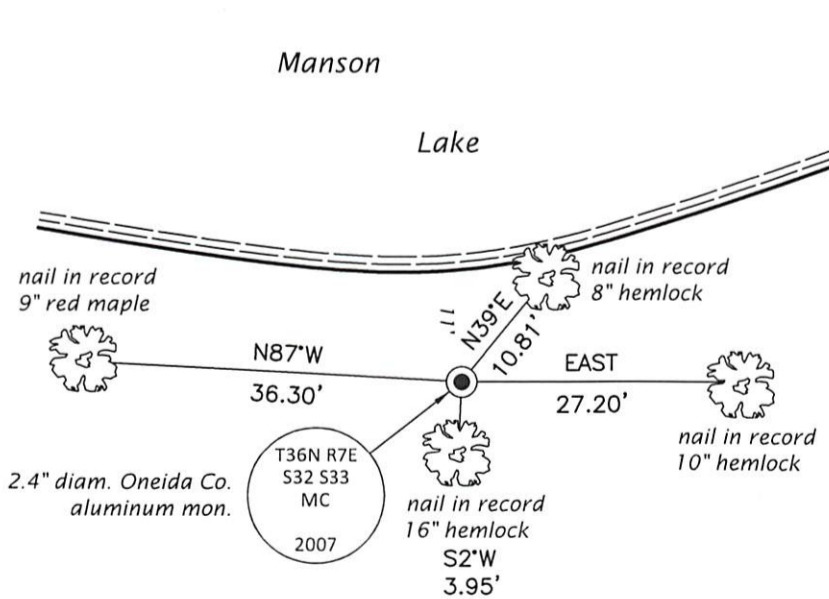


Magnetic
1" = 20'

REGISTER OF DEEDS OFFICE
ONEIDA COUNTY
FILED

AUG 02 2022

KYLE J. FRANSON
REGISTER OF DEEDS

(i) I, Jeffrey W. Austin, Professional Land Surveyor No. S-1885, hereby certify that the corner location on this record was determined by me or under my direction and control and that this U.S. Public Land Survey Monument Record is correct and complete to the best of my knowledge and belief.

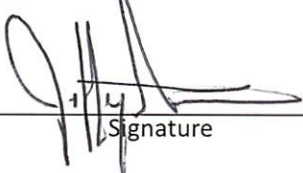
Signature

JUNE 1, 2022
Date

3607320600 (INDEX NO. Y,Z-9)