

U.S. PUBLIC LAND SURVEY MONUMENT RECORD


Note: This form is intended and designed to fulfill all requirements of Wisconsin Administrative Code, Chapter A-E 7.08 U.S. Public Land Survey Monument Record (3) (a) (b) (c) (d) (e) (f) (g) (h) (i). An additional sheet may be added if necessary to conform with said requirements.

(a) Corner location: Township 36 North

Range 7 East West

Town/City/Village Woodboro

County Oneida

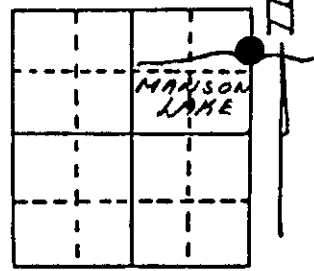

Section 32

(b) (f) (g) (h) Description of monument found at this corner and if it was accepted, state all evidence (material, testimonial, occupational, plats, records, other monuments) used as a basis for accepting. If not accepted or if nothing was found, state evidence used as basis for establishing location. If reestablished through lost corner proportionate methods, indicate all monuments, distances and directions used to establish. Indicate type of monument found or set and sign post.

November 1862 - Joseph H. Jenkins established corner and set a wood post with BTs:
 10" Y. Pine, N88°W, 12 Links 10" Y. Pine, N74°E, 27 Links


7/27/1989 - Milo E. Stefan found 2" iron pipe with BT, N70°W, 24.8'. This iron pipe was used as Meander Corner to "Plat of Breezy Point". No evidence of original survey remains. I accept this iron pipe as the perpetuated position of the original corner.

We placed a Oneida County Monument with new BTs and plastic sign post.

(c) (d) (e) Plan view of corner with ties to at least 4 witness monuments. If in disagreement with previously established corner, show the distances between the two corners and also indicate the ties to the disputed corner.

- 1) 2" x 30" Aluminum ONEIDA County Monument
Iron Pipe buried along side.
- 2) Southwest corner to "Wayside Bar", N48°E, 19.52'
- 3) 20" White Pine, N88°E, 51.56'
- 4) 14" Red Pine, N70°E, 25.60'
- 5) 10" Red Pine, N18°W, 83.25'
- 6) Plastic sign post, NE, .3'

Distances to nail in side of BTs.
 BTs scribed "BT" in stump blaze.

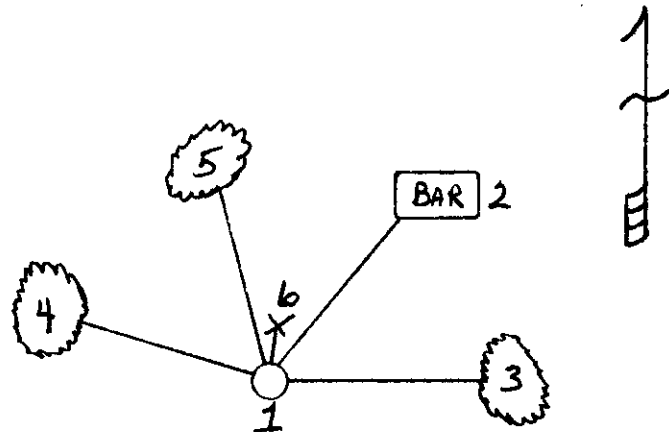

(i) I, Milo E. Stefan
 (type or print name) certify that the corner location on this record was determined by me or under my direction and control and that this U.S. Public Land Survey Monument Record is correct and complete to the best of my knowledge and belief.

Milo E. Stefan
 Signature

8/5/89
 Date



Index No. V, W-9

3607323400