U.S. PUBLIC LAND SURVEY MONUMENT RECORD

Note: This form is intended and designed to fulfill all requirements of Wisconsin Administrative Code, Chapter A-E 7.08 U.S. Public Land Survey Monument Record (3) (a) (b) (c) (d) (e) (f) (g) (h) (i). An additional sheet may be added if necessary to conform with said requirements.

(a) Corner location: Township 36 North

Range 7 East/West

Town/City/Village Woodboro

County Oneida

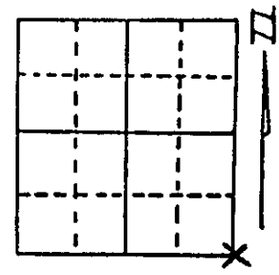

Section 34

(b) (f) (g) (h) Description of monument found at this corner and if it was accepted, state all evidence (material, testimonial, occupational, plats, records, other monuments) used as a basis for accepting. If not accepted or if nothing was found, state evidence used as basis for establishing location. If reestablished through lost corner proportionate methods, indicate all monuments, distances and directions used to establish. Indicate type of monument found or set and sign post.

8/30/1860 - Alfred Millard established this corner at 80.00 chains and set a wood post:
6" Spruce, S26°E, 19 links
12" Tamarack, S21°W, 14 links
9" Spruce, N51°W, 11 links

Owens-Illinois placed a 4" x 4" x 4' cedar post, scribed for section corner at fence corner and made two BTs:
8" Black Spruce, S28°W, 4.36'
6" Black Spruce, N68°W, 7.90'
Also, a 1 1/4" x 42" iron pipe along side cedar post.

1/15/1989 - Milo E. Stefan found iron pipe and post tipped out and Owens-Illinois' BTs in good condition. Remains of Tamarack BT at S21°W, 9.2'. I accept this as a perpetuated original corner and monument same.

(c) (d) (e) Plan view of corner with ties to at least 4 witness monuments. If in disagreement with previously established corner, show the distances between the two corners and also indicate the ties to the disputed corner.

1. 2" x 36" Oneida County Aluminum Monument.
*2. 6" Black Spruce, N25°E, 27.36'
*3. 4" Black Spruce, S82°E, 8.53'
**4. 8" Black Spruce, S28°W, 4.36'
**5. 6" Black Spruce, N68°W, 7.90'
6. Plastic sign post, next to monument.

*Trees scribed at base "BT"
**Trees by O-I, 15-20 years ago

Distances to nail in side of trees.

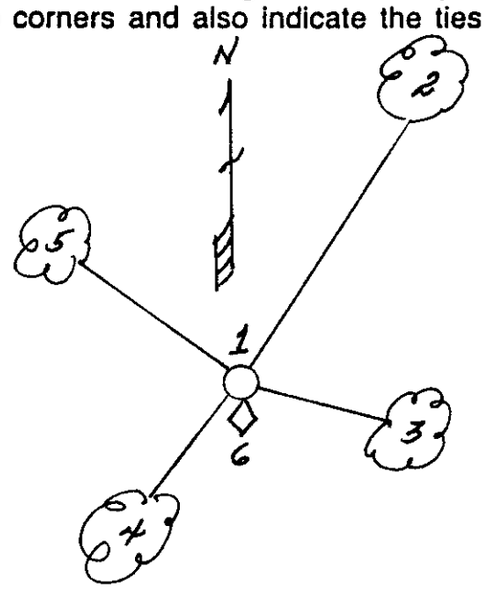

(i) I, Milo E. Stefan (type or print name) **certify that the corner location on this record was determined by me or under my direction and control and that this U.S. Public Land Survey Monument Record is correct and complete to the best of my knowledge and belief.**

Milo E. Stefan — 2/16/89

Signature — Date

WISCONSIN MILO E. STEFAN S-1558 RHINELANDER, WIS. LAND SURVEYOR

Index No. Z-17

36C7340CCC