U.S. PUBLIC LAND SURVEY MONUMENT RECORD

Note: This form is intended and designed to fulfill all requirements of Wisconsin Administrative Code, Chapter A-E 7.08 U.S. Public Land Survey Monument Record (3) (a) (b) (c) (d) (e) (f) (g) (h) (i). An additional sheet may be added if necessary to conform with said requirements.

(a) Corner location: Township 36 North

Range 8 East/[redacted]

~~Town~~/City/~~Village~~ Rhinelander

County Oneida

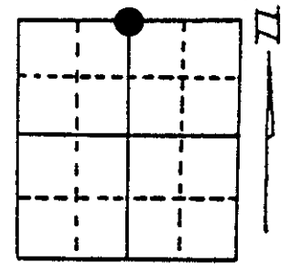

Section 11

(b) (f) (g) (h) Description of monument found at this corner and if it was accepted, state all evidence (material, testimonial, occupational, plats, records, other monuments) used as a basis for accepting. If not accepted or if nothing was found, state evidence used as basis for establishing location. If reestablished through lost corner proportionate methods, indicate all monuments, distances and directions used to establish. Indicate type of monument found or set and sign post.

-1863 Daugherty 40.42 ch. set Post Birch 8" S 82 E 18 lks.
Birch 8" N 20 W 16 lks.
-1896 Dorr at corner.
-1917 Vaughan at corner.
-1931 Hall found Vaughans bearings and set 6" x 6" Conc. Monument with X on top.
-1934 U.S. Surveyor Craig found 6" x 6" Conc. Monument
-1942 T.M. Wardwell found concrete monument.
-1968 Drivas at corner, found concrete monument.
-1989 W.E. Bandow replaced corner position and witnessed as shown below. This corner was not proportioned but was replaced in the position found by Hall, Craig, Wardwell & Drivas.

(c) (d) (e) Plan view of corner with ties to at least 4 witness monuments. If in disagreement with previously established corner, show the distances between the two corners and also indicate the ties to the disputed corner.

NOTE:

BEARINGS TAKEN WITH HANDHELD MAGNETIC COMPASS

NO SCALE

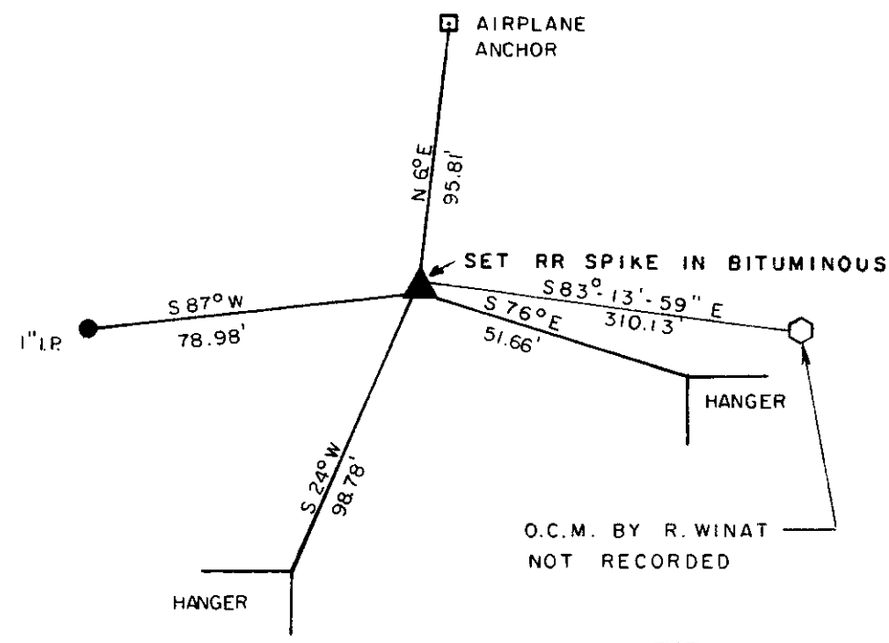

REGISTER OF DEEDS OFFICE
ONEIDA COUNTY, WIS
FILED
FEB 7 1991
At _____ O'Clock _____ M
THOMAS H. LEIGHTON
REGISTER OF DEEDS

(i) I, William E. Bandow (type or print name) certify that the corner location on this record was determined by me or under my direction and control and that this U.S. Public Land Survey Monument Record is correct and complete to the best of my knowledge and belief.

William E. Bandow 2-1-91

Signature Date

WISCONSIN WILLIAM E. BANDOW S-1082 RHINELANDER WIS. LAND SURVEYOR

Index No. E-19

36080 20020