


This form is intended to fulfill the requirements of Chapter A-E7.08 (3)(a) thru (i) U.S. Public Land Survey Monument Location Record, Wisconsin Administrative Code. Use the reverse side of form for continuation.

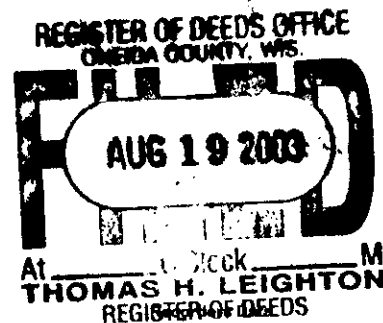

**U.S. PUBLIC LAND SURVEY MONUMENT LOCATION RECORD**

USPLS CORNER: NORTH WITNESS MC SECTION: 8 TOWNSHIP: 36 NORTH RANGE: 8 EAST  
 NAME OF WATERWAY FOR M.C. CORNER: CRESCENT LAKE SECTION LINE: WEST  
 (CITY)(VILLAGE)(TOWN) OF: CRESCENT COUNTY OF: ONEIDA

Description of monument found or placed and all other evidence used as the basis for monument location; including monuments and measurements required if the corner location was reestablished by lost corner proportionate methods. Also indicate name of the original surveyor, original survey date and the corner monument, bearing trees, witness or other reference monuments established, including measured bearing and distance ties, from available survey records.


Found and accepted an old 1" dia. iron pipe with coupling and orange flagging at top flush with existing grade, which I carefully removed together with a 1.5" dia. iron pipe with a 1/2" iron pipe inside of it along the northerly side of the 1" dia. iron pipe and drove a standard 2" dia. by 30" long aluminum pipe monument with stamped Oneida County cap flush into the plumb soil cavity left below grade by the 1" dia. old iron pipe. I left the old iron pipes flat on grade next to a standard white poly 'T' marker post set 4 feet south of the corner monument which falls 8.5' North of lakeshore bearing N60°E.

In July 1863, William E. Daugherty/GLO set a wood post as the original MC and noted OBTs: a 7" Hemlock N43°E 7 links and a 7" Hemlock S37°W 3 links; all now obliterated.

In August 1923, D.H. Vaughan notes this witness MC location on Plat of Crescent Bay filed in Cabinet 1 Sheet 167 Oneida County records. In November 1924, C.D. Vaughan notes an "iron" at this witness MC location per Plat of Rodd's Addition To Crescent Bay filed in Cabinet 2 Sheet 19 Oneida County records. In April 1988, Todd Loftus/RLS 1523 notes Vaughans MC at N39°43'05"E 4.00' from a 1" iron pipe he found at the SW corner of his Plat of Survey filed as B-1975 in Oneida County survey records, but does not describe any monument at Vaughans MC, which undoubtedly had been the old iron pipe I found at the MC only 5 years later N42°E 4.10' from the latter Plat of Survey corner pipe noted by Loftus.


This recovery witnessed by adjacent lot owner Joseph Fochs at Fire No. 6993 USH 8 who had retained Surveyor Loftus.

Plan view map of monument location with bearing and distance ties to a minimum of four(4) described witness or reference monuments of concrete, natural stone, iron, live bearing trees or equivalent material. If applicable, also show a minimum of two(2) bearing and distance ties to any other monument found and not accepted; including the bearing and distance from the accepted monument.

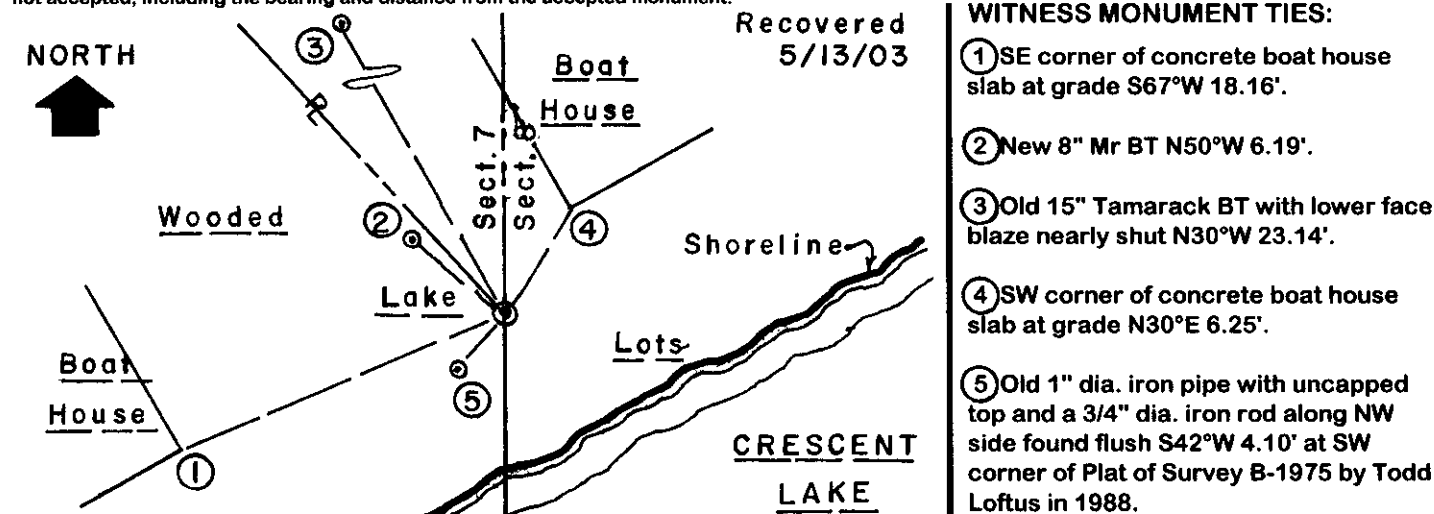

Unless otherwise indicated, all bearing tree ties are to a .25" dia. by 2.5" long PK nail with a 1.25" dia. steel washer driven into unblazed right face and a .25" dia. by 2.5" long PK nail with a 2" dia. steel washer stamped BT is also driven into unblazed face of bearing tree at DBH; the basis for measured bearings is by compass to nearest degree and all tie distances are measured horizontal by steel tape corrected to nearest 1/100th feet at standard temperature of 68° F.

RLS SEAL:

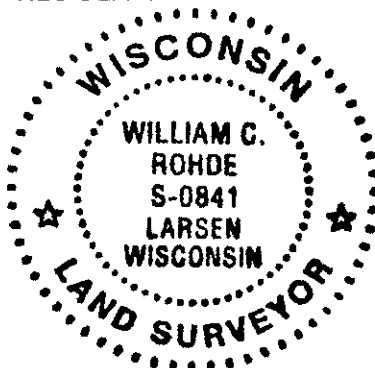

LAND SURVEYOR CERTIFICATE:

I, William C. Rohde, hereby certify that I am duly licensed as a Professional Land Surveyor in the State of Wisconsin; that this USPLS monument location was determined by me and/or under my direct supervision and control; and that this U.S. Public Land Survey Monument Location Record is true and correct to the best of my knowledge and belief.

Signed William C. Rohde  
 William C. Rohde RLS 841

