

This form is intended to fulfill the requirements of Chapter A-E 7.08 (3)(a) thru (l) U.S. Public Land Survey Monument Location Record, Wisconsin Administrative Code. Use the reverse side of form for continuation.

U.S. PUBLIC LAND SURVEY MONUMENT LOCATION RECORD

USPLS CORNER: WEST 1/4 CORNER SECTION: 9 TOWNSHIP: 36 NORTH RANGE: 8 EAST

NAME OF WATERWAY FOR M.C. CORNER : N/A SECTION LINE: N/A

(CITY)(VILLAGE)(TOWN) OF: CRESCENT COUNTY OF: ONEIDA


Description of monument found or placed and all other evidence used as the basis for monument location; including monuments and related measurements required if the corner location was reestablished by lost corner proportionate methods. Also indicate name of original surveyor, original survey date and the corner monument, bearing trees, witness or other reference monuments established; including measured bearing and distance ties, from available records.

Found a standard 2" dia. aluminum pipe monument with Oneida County cap 3" up and stamped in 1997 as this 1/4 corner by unknown surveyor; a standard white poly 'T' marker post was also found 12" south of the monument. Corner falls on the east edge of unimproved woods road bearing N15°E and S30°W. Lines are flagged East and North by recent survey.

- In July 1863, William E. Daugherty/GLO set a wood post as original corner and marked OBTs: an 8" Birch N36°W 18 links and a 10" Hemlock S47°E 11 links; all are now obliterated.
- In July 1967, James G. Griffin/RLS 755 indicates this corner, but not described, and noted new BTs: a 10" Oak S57°E 34.0', now a 15" Oak S61°E 36' as large rocks at 34'; a 7" Oak N58°W 10.6', now gone; a 9" Oak N38°W 17.0', now a 14" Oak N30°W 17' and a 9" Oak S54°W 23.1', now a 12" Oak S58°W 23'; all BTs with no visible markings. I also found four(4) other old BTs which I used for new ties below. In September 1967, Griffin indicates a 2" iron pipe at this corner and same four BTs per Plat of Royal Oak Estates filed in Cabinet 2 Sheet 124 at Oneida County Register of Deeds office.
- In August 1978, Robert H. Winat/RLS 1040 notes this corner by reference measure on Certified Survey Map filed in Volume 3 of Maps Pages 635 & 635A Oneida County records; corner not described nor BTs noted.
- In April 1982, Lester Schmit/RLS 1192 notes a 1.25" dia. iron pipe found at this corner per Plat of Survey filed as B-3363 in Oneida County survey records.
- In November 1986, Todd Loftus/RLS 1523 notes a 2" iron pipe found at this corner per Plat of Survey filed as B-1534 in Oneida County survey records.

This recovery completed November 19, 2002; there were no direct witnesses.

Plan view map of monument location with bearing and distance ties to a minimum of four(4) described witness or reference monuments of concrete, natural stone, iron, live bearing trees or equivalent material. If applicable, also show a minimum of two(2) bearing and distance ties to any other monument found and not accepted; including the bearing and distance from the accepted monument.

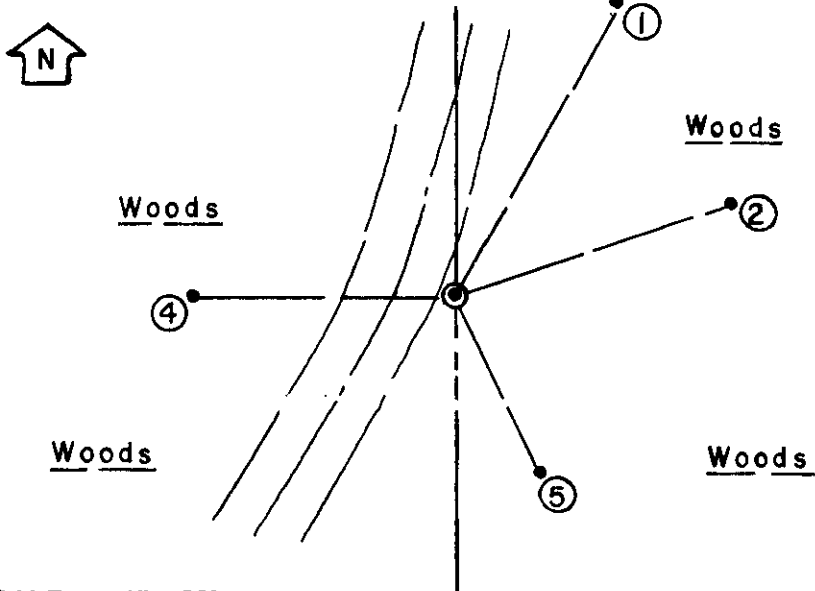

WITNESS MONUMENT TIES:

- ① Old 16" Oak BT N29°E 38.91' to new PK/W in left face as old PK overgrown in right face.
- ② Old SW 11" Oak BT of double N70°E 30.07' to old PK nail in left face.
- ③ Old 11" Oak BT S27°E 20.44' to new PK/W in right face as old PK is overgrown in right face.
- ④ Old 14" Oak BT West 27.11' to old PK in right face.

All old BTs have a plain upper & lower face blaze which I painted blaze orange.

SCALE: 1" = 20'

Unless otherwise indicated, all bearing tree ties are to a .25" dia. by 2.5" long PK nail with a 1.25" dia. steel washer driven into unblazed right face and a .25" dia. by 2.5" long PK nail with a 2" dia. steel washer stamped BT is also driven into unblazed face of bearing tree at DBH; the basis for measured bearings is by compass to nearest degree and all tie distances are measured horizontal by steel tape corrected to nearest 1/100th feet at standard temperature of 68° F.


RLS SEAL:



LAND SURVEYOR CERTIFICATE:

I, William C. Rohde, hereby certify that I am duly licensed as a Professional Land Surveyor in the State of Wisconsin; that this USPLS monument location was determined by me and/or under my direct supervision and control; and that this U.S. Public Land Survey Monument Location Record is true and correct to the best of my knowledge and belief.

Signed: *William C. Rohde*
William C. Rohde RLS 841

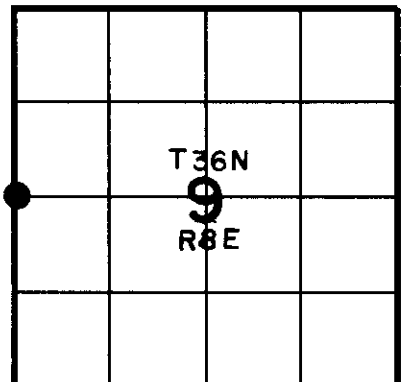

SECTION LOCATION MAP

INDEX NO. 67

3608082000