


U.S. PUBLIC LAND SURVEY MONUMENT RECORD

Note: This form is intended and designed to fulfill all requirements of Wisconsin Administrative Code, Chapter A-E 7.08 U.S. Public Land Survey Monument Record (3) (a) (b) (c) (d) (e) (f) (g) (h) (i). An additional sheet may be added if necessary to conform with said requirements.


(a) Corner location: Township 36 North
 Range 8 East/West
 Town/City/Village Crescent
 County Oneida

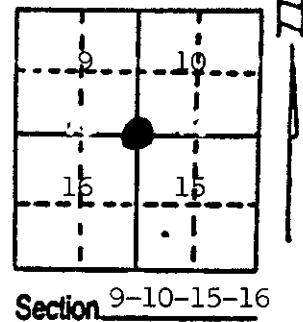

(b) (f) (g) (h) Description of monument found at this corner and if it was accepted, state all evidence (material, testimonial, occupational, plats, records, other monuments) used as a basis for accepting. If not accepted or if nothing was found, state evidence used as basis for establishing location. If reestablished through lost corner proportionate methods, indicate all monuments, distances and directions used to establish. Indicate type of monument found or set and sign post.

July, 1863, Original survey by William Dougherty 80 chains set post and made
 B.T.s Aspen 15" N50° E 21 Links
 Birch 12" S41° E 16 Links

1939 GLO Dependant Resurvey and Extension Survey of Sections 16 and 21 by Hal Craing. Corner position was set by proportional distance as no remaining evidence of original corner or accessories was found. Set a concrete Monument 24", 6" dia., for section corner with brass tablet marked as follows: T36N R8E

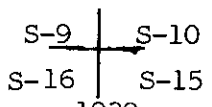


B.T.s Elm 14" N 40 3/4° E 294 links, 1939 marked T36N R8E S10 BT
 Norway Pine 16" S 26 1/2° E 376 Links, marked T36N R8E S15 BT
 Red Oak 14" S 56 3/4° W 157 Links marked T36N R8E S 16 BT


Feb. 1989 I found existing GLO Brass Cap with a RIPCO monument along side 18" above ground.

(c) (d) (e) Plan view of corner with ties to at least 4 witness monuments. If in disagreement with previously established corner, show the distances between the two corners and also indicate the ties to the disputed corner. Bearings and distances taken from GLO monument to a 4" spike in the side of the B.T.

1. Local B.T. White Pine 9" S 74° W 42.98'
2. New B.T. White Pine 7" N 23° E 47.90'
3. New B.T. Red Pine 7" S 07° W 28.27'
4. Local B.T. Red pine 5" N 33° W 28.26'
5. Location tag on 9" Aspen N 78° W 9.15'
6. Sign Post SW 1.15'

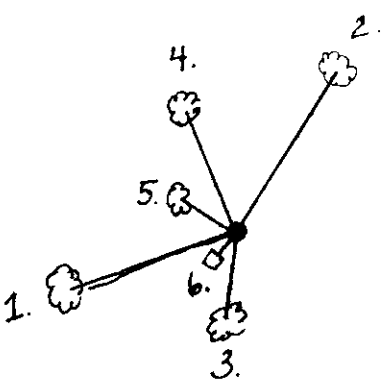

Bearings taken with a handheld compass

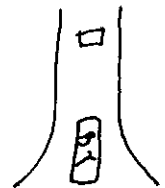

Typical scribed B.T.

(i) I, Richard J. Belliveau
 (type or print name) certify that the corner location on this record was determined by me or under my direction and control and that this U.S. Public Land Survey Monument Record is correct and complete to the best of my knowledge and belief.

Richard J. Belliveau 7/13/89
 Signature Date



Index No. 7-13

3608090000