


U.S. PUBLIC LAND SURVEY MONUMENT RECORD

Note: This form is intended and designed to fulfill all requirements of Wisconsin Administrative Code, Chapter A-E 7.08 U.S. Public Land Survey Monument Record (3) (a) (b) (c) (d) (e) (f) (g) (h) (i). An additional sheet may be added if necessary to conform with said requirements.


(a) Corner location: Township 36 North
 Range 8 East/West
 Town/City/Village Crescent
 County Oneida

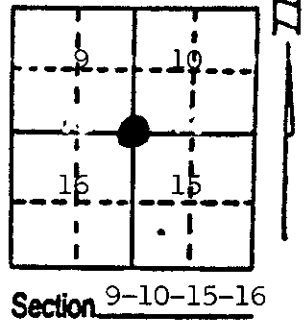

(b) (f) (g) (h) Description of monument found at this corner and if it was accepted, state all evidence (material, testimonial, occupational, plats, records, other monuments) used as a basis for accepting. If not accepted or if nothing was found, state evidence used as basis for establishing location. If reestablished through lost corner proportionate methods, indicate all monuments, distances and directions used to establish. Indicate type of monument found or set and sign post.

July, 1863, Original survey by William Dougherty 80 chains set post and made
 B.T.s Aspen 15" N50° E 21 Links
 Birch 12" S41° E 16 Links


1939 GLO Dependant Resurvey and Extension Survey of Sections 16 and 21 by Hal Craing. Corner position was set by proportional distance as no remaining evidence of original corner or accessories was found. Set a concrete Monument 24", 6" dia., for section corner with brass tablet marked as follows: T36N R8E

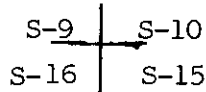


B.T.s Elm 14" N 40 3/4° E 294 Links, ¹⁹³⁹ marked T36N R8E S10 BT
 Norway Pine 16" S 26 1/2° E 376 Links, marked T36N R8E S15 BT
 Red Oak 14" S 56 3/4° W 157 Links marked T36N R8E S 16 BT
 Feb. 1989 I found existing GLO Brass Cap with a RIPCO monument along side 18" above ground.

(c) (d) (e) Plan view of corner with ties to at least 4 witness monuments. If in disagreement with previously established corner, show the distances between the two corners and also indicate the ties to the disputed corner. Bearings and distances taken from GLO monument to a 4" spike in the side of the B.T.

1. Local B.T. White Pine 9" S 74° W 42.98'
2. New B.T. White Pine 7" N 23° E 47.90'
3. New B.T. Red Pine 7" S 07° W 28.27'
4. Local B.T. Red pine 5" N 33° W 28.26'
5. Location tag on 9" Aspen N 78° W 9.15'
6. Sign Post SW 1.15'

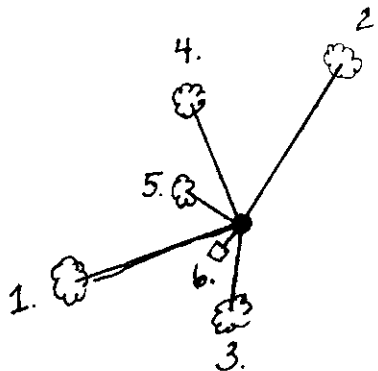

Bearings taken with a handheld compass

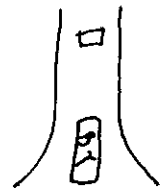

Typical scribed B.T.

(i) I, Richard J. Belliveau
 (type or print name) certify that the corner location on this record was determined by me or under my direction and control and that this U.S. Public Land Survey Monument Record is correct and complete to the best of my knowledge and belief.

Richard J. Belliveau 7/13/89
 Signature Date



Index No. 5-13

3608090000

JUN 12 2023

US PUBLIC LAND SURVEY MONUMENT RECORD


KYLE J. FRANSON
REGISTER OF DEEDS

Per Wis. Admin. Code § A-E 7.08, a U.S. public land survey monument record shall be prepared and filed with the county survey records as part of any land survey within 60 days of setting or accepting the corner, which includes or requires the perpetuation, restoration, or use of a U.S. public land survey corner and when any of the situations in Wis. Admin. Code § A-E 7.08(1)(a), 7.08(1)(b) or 7.08(1)(c) arise.

3(a) Corner location:

Found a brass GLO cap set in a concrete monument with a RIPCO monument adjacent Southeast Corner Section 09 Township 36 North Range 8 East 4th Principal Meridian Town of Crescent Oneida Co., WI

WISCRS:
N:
E:
Datum:
GNSS Control:
GNSS Method:
Verification Method:

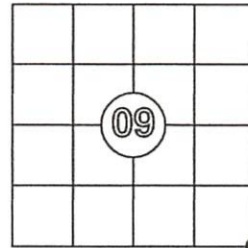

CORNER ID:
3608090000

(b) History of Original Corner Establishment

Corner Set: Wood Post
Original Surveyor: Wm. Daugherty
Date of Survey: July, 1863

Original Bearing Trees:
Aspen, 15" N 50° E, 21 links
Birch, 12" S 41° E, 16 links

(b)(f)(g)(h) Description of monument found at this corner and, if it was accepted, state all evidence (material, testimonial, occupational, plats, record, other monuments) used as a basis for establishing location. If re-establishing through lost corner proportionate methods, indicate all monuments, distances and directions used to establish this location. Indicate type of monument and sign post found or set.


This is a continuation of a previous USPLSS Monument Record by Surveyor Richard Belliveau (1989). See previous record for additional history on this corner.

- 7/12/1993: Todd Loftus notes a GLO monument (O.C. Map No. L1242).
- 7/12/1994: Todd Loftus notes a GLO monument (CSM 1699).
- 1/31/2000: WI DoT Project No. 1593-05-21 notes a brass cap in concrete.
- 2/12/2013: Gene Uttech notes a 6" concrete monument (O.C. Map No. A2756)
- 8/19/2013: Kevin Bixby notes an existing GLO monument (CSM 4172).
- 11/9/2021: Charles Oleinik notes a found brass monument (O.C. Map No. A3851).
- 6/11/2023: I found a General Land Office brass disk set in concrete in good condition. There is a 1" iron pipe with a RIPCO cap adjacent to the concrete.

(4). I recovered and set witnesses, as shown below. As all the blazes have grown over, I drove a 6" spike into each tree and made new distances. Bearings were taken with a hand-held compass. Witness listed on the previous record, not shown here, were not recovered.

(c)(d)(e) Plan view of corner with ties to at least 4 witness monuments. If in disagreement with previously established corner, show the distances between the two corners and also indicate the ties to the disputed.

1. Set 6" spike in 14" aspen (found), S 74° W, 42.50'a
Not a 9" white pine as noted on the previous record.
2. Set 6" spike in 9" aspen with location tag (found), N 55° E, 9.84'
3. Set 6" spike in 12" maple (found), N 15° E, 14.97'.
4. Set 6" spike in 24" white pine (found), N 23° E, 48.08'.
5. Set 6" spike in 12" aspen (new), S 40° W, 12.55'
6. Plastic, white sign post, SW 1.15'

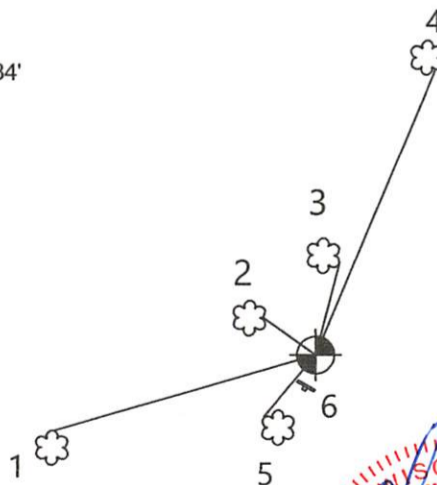

Bearings: Magnetic
Scale: 1"=30'



Anthony R. Jones
WISCONSIN
Anthony Jones
S-2508
Rhinelander
WI
LAND SURVEYOR
6/12/23

(i) I, Anthony R. Jones, Wisconsin Professional Land Surveyor No S-2508, hereby certify that the corner location shown on this record was determined by me, or under my direction or control, and that this U.S. Public Land Survey Monument Record is correct and complete to the best of my knowledge and belief.

Anthony R. Jones, PLS No. S-2508

Date

Index No. J-13