


U.S. PUBLIC LAND SURVEY MONUMENT RECORD

Note: This form is intended and designed to fulfill all requirements of Wisconsin Administrative Code, Chapter A-E 7.08 U.S. Public Land Survey Monument Record (3) (a) (b) (c) (d) (e) (f) (g) (h) (i). An additional sheet may be added if necessary to conform with said requirements.


(a) Corner location: Township 36 North
 Range 8 East/West
 Town/City/Village Crescent
 County Oneida

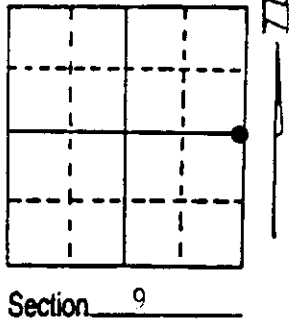

(b) (f) (g) (h) Description of monument found at this corner and if it was accepted, state all evidence (material, testimonial, occupational, plats, records, other monuments) used as a basis for accepting. If not accepted or if nothing was found, state evidence used as basis for establishing location. If reestablished through lost corner proportionate methods, indicate all monuments, distances and directions used to establish. Indicate type of monument found or set and sign post.

- 1863-Daugherty set post, 10" White Pine S 39 E 50 links, 10" pine N 32 W 16 links
- 1897-Door at post
- 1939-G.L.O. found an oak post 4" square firmly set with 30" of it above ground. Set an iron post 36" long, 1" in diameter, 28" in the ground for the $\frac{1}{4}$ section corner with brass cap found remains of original B.T.s: badly burned pine stump bears S 40 degrees E, 50 links, a dim stump hole bears N 32 degrees W, 16 links, made new B.T.s a maple 8" in diameter bears S 76 E, 176 links marked $\frac{1}{4}$ S. 10 B.T. a norway pine 10" diameter bears N 78 degrees W, 256 links, marked $\frac{1}{4}$ S. 9 B.T.
- 1968-George Drivas found G.L.O. pipe
- 1971-N. Loftus found G.L.O. monument
- 1976-Stuart Foltz found G.L.O. brass cap 10" norway pine N 84 degrees E 32.2', 10" norway pine S 7 degrees W 2.7'
- 1993-William Bandow found G.L.O. monument stamped as shown below and witnessed.

(c) (d) (e) Plan view of corner with ties to at least 4 witness monuments. If in disagreement with previously established corner, show the distances between the two corners and also indicate the ties to the disputed corner.

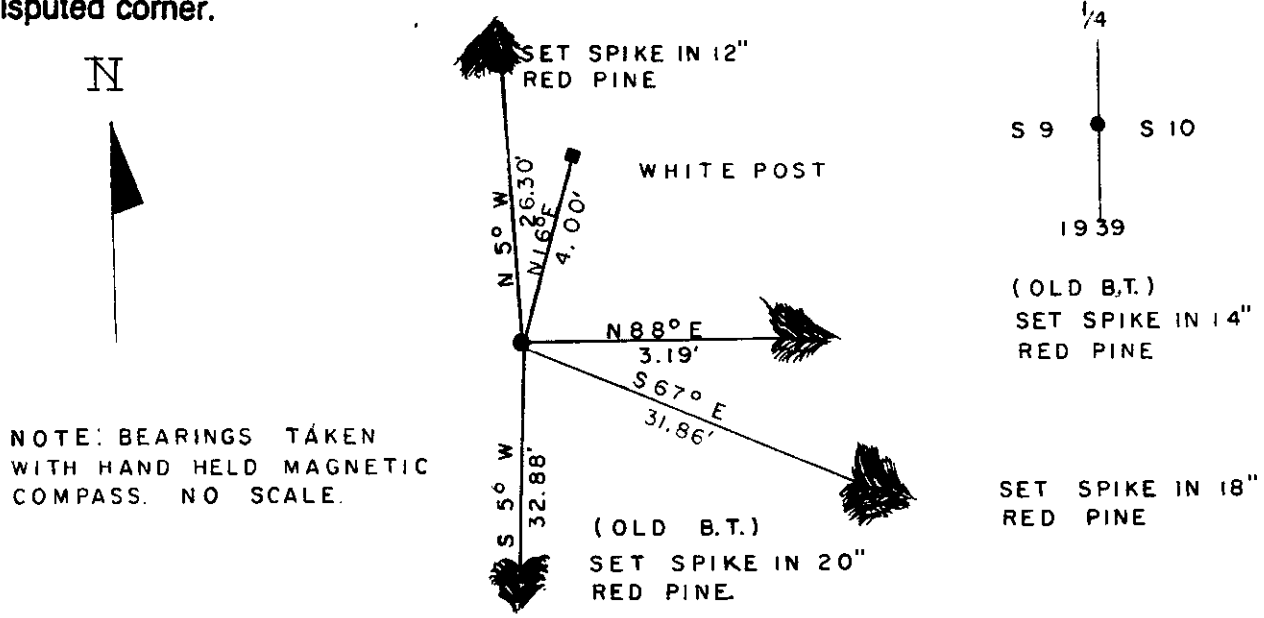

NOTE: BEARINGS TAKEN WITH HAND HELD MAGNETIC COMPASS. NO SCALE.

(i) William E. Bandow
 (type or print name) certify that the corner location on this record was determined by me or under my direction and control and that this U.S. Public Land Survey Monument Record is correct and complete to the best of my knowledge and belief.

William E. Bandow 12-29-93
 Signature Date



Index No. G-13


3608092000 Stamp

U.S. PUBLIC LAND SURVEY MONUMENT RECORD

Note: This form is intended and designed to fulfill all requirements of Wisconsin Administrative Code, Chapter A-E 7.08 U.S. Public Land Survey Monument Record (3)(a-i).

(a) CORNER LOCATION
 1/4 Cor. of Secs. 9 & 10
 Township 36 North
 Range 8 East of the 4th P.M.
 Town of Crescent
 County of Oneida

WISCRS - Oneida County
 N: 158,571.05 USft
 E: 243,801.21 USft
 Datum: NAD 83(2011)
 GNSS Method: RTN - Offset
 GNSS Control: WISCORS VRS

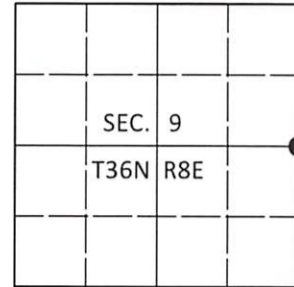

(b) HISTORY OF ORIGINAL CORNER ESTABLISHMENT

Original Surveyor: _____ Original Accessories: _____
 Date of Survey Commenced: _____ See previous monument record(s)
 Completed: _____

(b)(f)(g)(h) Description of monument found at this corner and if it was accepted, state all evidence (material, testimonial, occupational, plats, records, other monuments) used as a basis for accepting. If not accepted or if nothing was found, state evidence used as basis for establishing location. If re-established through lost corner proportionate methods, indicate all monuments, distances and directions used to establish. Indicate type of monument and sign post found or set.


This is a perpetuation of the following monument record(s) that comprise a complete history of the corner:

Dec. 29, 1993: USPLS Monument Record No. 3608092000 by William E. Badow, PLS

Oct. 3, 2020: I found and accepted the record monument, a 1.0" diam. iron pipe with a 2.5" diam. GLO brass cap projecting 12" above a collar of stone. I found or established accessories as shown below. I found a white vinyl sign post bearing N15°E, 4.2 ft.

The coordinate value shown has been verified by at least one of the following methods: 1) comparison to a previously GPS determined published value; 2) the value is the average of two or more GPS observations at a markedly different time; 3) one or more distances were measured back to the GPS observed corner from temporary GPS observed offset locations.

(c)(d)(e) Plan view of corner with ties to at least 4 witness monuments. If in disagreement with previously established corner, show the distances between the two corners and also indicate the ties to the disputed.

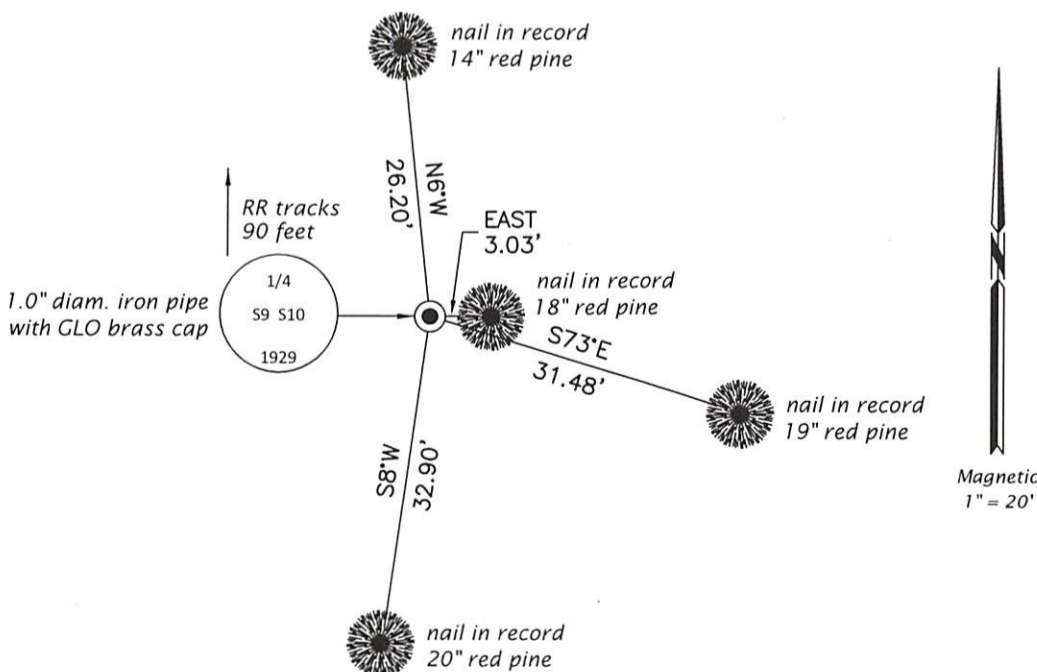

REGISTER OF DEEDS OFFICE
 ONEIDA COUNTY
 FILED

JAN 13 2021

KYLE J. FRANSON
 REGISTER OF DEEDS

(i) I, Jeffrey W. Austin, Professional Land Surveyor No. S-1885, hereby certify that the corner location on this record was determined by me or under my direction and control and that this U.S. Public Land Survey Monument Record is correct and complete to the best of my knowledge and belief.

 Signature 15 DEC 2020
Date