U.S. PUBLIC LAND SURVEY MONUMENT RECORD

Note: This form is intended and designed to fulfill all requirements of Wisconsin Administrative Code, Chapter A-E 7.08 U.S. Public Land Survey Monument Record (3) (a) (b) (c) (d) (e) (f) (g) (h) (i). An additional sheet may be added if necessary to conform with said requirements.

(a) Corner location: Township 36 North

Range 8 East/~~West~~

Town/~~City/Village~~ Crescent

County Oneida

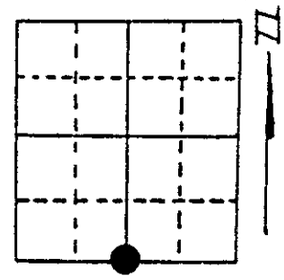

Section 11

(b) (f) (g) (h) Description of monument found at this corner and if it was accepted, state all evidence (material, testimonial, occupational, plats, records, other monuments) used as a basis for accepting. If not accepted or if nothing was found, state evidence used as basis for establishing location. If reestablished through lost corner proportionate methods, indicate all monuments, distances and directions used to establish. Indicate type of monument found or set and sign post.

-1863- Daugherty 40.135 ch. set post W. Pine 15" S 47 E 26 lks., Birch 10" N 47 E 25 lks.

-1968- Ripco 40.23 ch. set corner Maple 3" S 46 W .248 ch., Oak 12" N 11 W .72 ch.

-1989- Bandow found Ripco Mon. witnessed as shown below W. Plastic Post SW .50'

(c) (d) (e) Plan view of corner with ties to at least 4 witness monuments. If in disagreement with previously established corner, show the distances between the two corners and also indicate the ties to the disputed corner.

NOTE:

MEASUREMENTS TAKEN FROM 6" SPIKE IN SIDE OF TREE

BEARINGS TAKEN WITH HANDHELD MAGNETIC COMPASS

NO SCALE

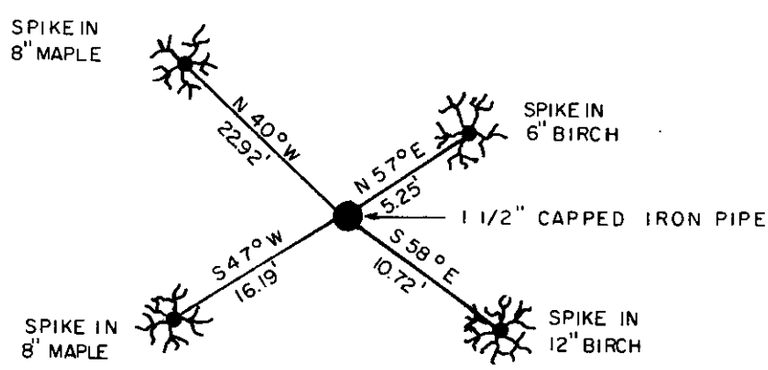

REGISTER OF DEEDS OFFICE
ONEIDA COUNTY, WIS
FILED
FEB 7 1991
At _____ O'Clock _____ M
THOMAS H. LEIGHTON
REGISTER OF DEEDS

(i) I, William E. Bandow (type or print name) certify that the corner location on this record was determined by me or under my direction and control and that this U.S. Public Land Survey Monument Record is correct and complete to the best of my knowledge and belief.

William E. Bandow 2-1-91

Signature Date

WISCONSIN WILLIAM E. BANDOW S-1152 RHINELANDER WIS. LAND SURVEYOR

Index No. J-19

36081/0020