

U.S. PUBLIC LAND SURVEY MONUMENT RECORD

Note: This form is intended and designed to fulfill all requirements of Wisconsin Administrative Code, Chapter A-E 5.02, U.S. Public Land Survey Monument Record (3) (a) (b) (c) (d) (e) (f) (g) (h) (i). An additional sheet may be added if necessary to conform with said requirements.


(a) Corner location: Township 36 North

Range 8 East

Town Crescent

County Oneida

Section 12

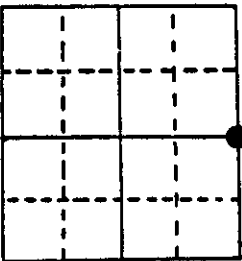

West Quarter
Corner

(b) (f) (g) (h) Description of monument found at this corner and if it was accepted, state all evidence (material, testimonial, occupational, plats, records, other monuments) used as a basis for accepting. If not accepted or if nothing was found, state evidence used as basis for establishing location. If reestablished through lost corner proportionate methods, indicate all monuments, distances and directions used to establish.


July 1863 - William E. Daugherty, Deputy Surveyor - Set quarter section post. Original bearing trees: Birch 14" S51°E, 39 lks.; Birch 12" N45°W, 25 lks.

May 1895 - B. F. Dorr, Oneida County Surveyor - W 1/4 P. Pine 18" S71°W, 44.5 lks. Pine 18" S6.5°E, 24.5 lks.

April 1948 - F. R. Wincentsen, Deputy County Surveyor - Round iron pipe (old). Round B. F. Dorr's S.E. B.T. New Elm 15 S66°E, 17.8'; Birch 8" S12°E, 27.4'.

August 5, 1985 - Found Oneida County brass capped 2" dia. iron pipe up 1 1/2 feet top of iron pipe bent south, bottom of pipe plumb and not disturbed, straightened and reset same monument plumb. Monument now extends 6" above ground level in the easterly ditch line of S. River Road 19 feet from centerline and 26 feet westerly from top bank of Wisconsin River Existing bearing tree, dead Elm S65°-19'E, 17.77'.


(c) (d) (e) Plan view of corner with ties to at least 4 witness monuments. If in disagreement with previously established corner, show the distances between the two corners and also indicate the ties to the disputed corner.

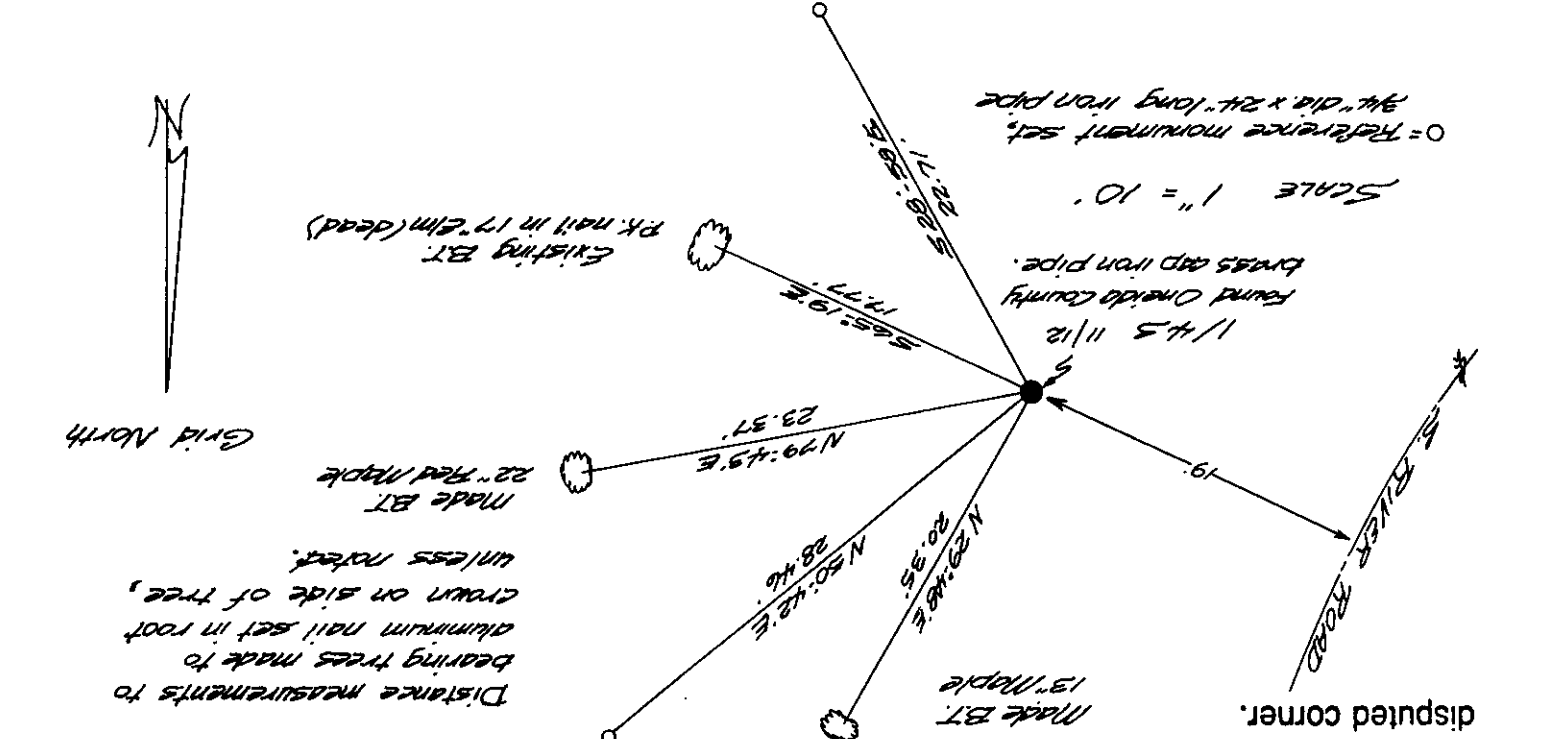

(f) I, James D. Rein, Reg. Land Surveyor No. S-1234 (type or print name) certify that the corner location on this record was determined by me or under my direction and control and that this U.S. Public Land Survey Monument Record is correct and complete to the best of my knowledge and belief.

Signature: *James D. Rein*
Date: October 19, 1985

3608112000

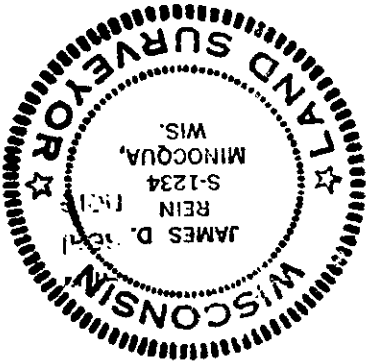

Index No. 6-21