



CERTIFIED LAND CORNER RESTORATION

State of Wisconsin }
County of Oneida } ss.

I, William Immich, do hereby certify that on the 20 day of Jan, 1982, I found evidence of the M.C. East shore Birch Lake corner of Sections 12 & 13 Township 36 North Range 8 East, Fourth Principal Meridian, as described hereon; and that from this evidence I established a new monument and accessories as described hereon to perpetuate the original location of this corner:

Description of original monument and accessories and subsequent restorations:

1863 William Daugherty Government Surveyor, East between 12 and 13
Var. 8° E 40.06' over lake and set meander post Birch 10 S 51 E 341k
Birch 7 N 45 E 101k

Description of corner evidence found:

- 1898 B.F. Dorr found corner calls it south 1/4 corner of Section 12 ran north from corner
- 1902 Dorr back at corner calls for bearing tree Hem 20 N27 1/2 E 40 1/2 k
- 1946 A.J. Lytle found post calls corner M.C. and 1/4 corner
- 1960 F.R. Wincentzen calls corner S 1/4 corner Section 12 calls for iron pipe, for plat of Olsons Timber Shores
- 1979 W. Immich found F.R. Wincentzens iron pipe fit plat good



Description of monument and accessories I established to perpetuate the location of this corner:

Found 2" iron pipe found old b.t.s Hem. 9 S46E 0.77'
Hem. 9 S78E 8.68'

reblazed these b/ts.

monument in good condition did not remonument made new bearing trees
Hemlock 8" N 43 E 12.30' Birch Lake West 3.9'

bearing trees scribed and blazed, distance to p.k. in blaze bearing mag.

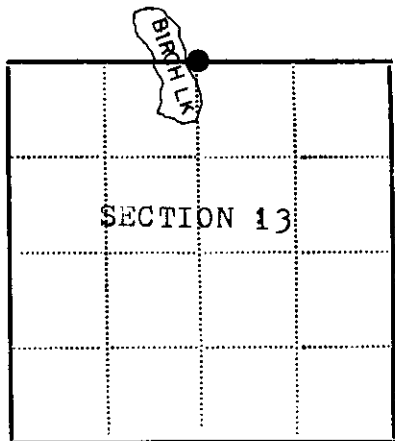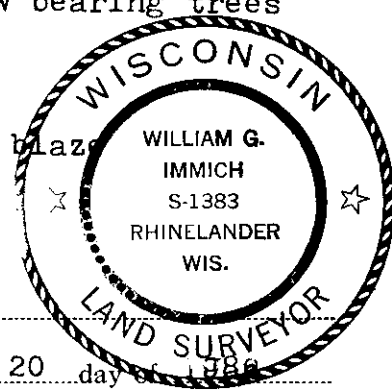

● - Corner monument restored
□ -

Resident witnesses.....
Dated at Rhinelander Wisconsin, this 20 day of Jan 1982.

Signature *William Immich* Title R.L.S.
(County Surveyor, Registered Land Surveyor, or other duly authorized official)

Surveyors Registration No. 1383

Office of Oneida County of Reg. of Deeds

I hereby certify that the within instrument was filed in this office for record on the 11 day of June 1986, and was filed in Book No. Page No. of County Records.

Signature *Doris Verage Kuchner* Title Reg. of Deeds
Cynthia A. Potts, Deputy

Township 36 North, Range 8 East, Section 13, Index No., Page No.

3608120020

5-23