


U.S. PUBLIC LAND SURVEY MONUMENT RECORD

Note: This form is intended and designed to fulfill all requirements of Wisconsin Administrative Code, Chapter A-E 5.02, U.S. Public Land Survey Monument Record (3) (a) (b) (c) (d) (e) (f) (g) (h) (i). An additional sheet may be added if necessary to conform with said requirements.

(a) Corner location: Township 36 North
 Range 8 East
 Town Crescent
 County Oneida

Meander Corner
 West shore of
 Birch Lake on
 South line of
 Section 12

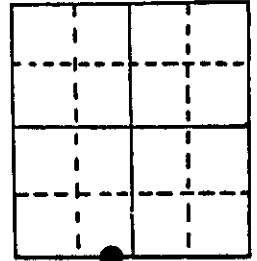

Section 12


(b) (f) (g) (h) Description of monument found at this corner and if it was accepted, state all evidence (material, testimonial, occupational, plats, records, other monuments) used as a basis for accepting. If not accepted or if nothing was found, state evidence used as basis for establishing location. If reestablished through lost corner proportionate methods, indicate all monuments, distances and directions used to establish.

July 1863 - William E. Daugherty, Deputy Surveyor - Set meander post
 Original bearing trees; Aspen 10 N43°W, 8 lks.; Aspen
 8 S72°W, 20 lks.

May 1898 - B. F. Dorr, Oneida County Surveyor - Did not note corner
 in survey record.


August 14, 1985 - Found 1 1/2" dia. iron pipe with coupling extending
 18" above ground level. Existing bearing tree 17"
 Red Pine bears S55°-25'W, 47.70 feet.

(c) (d) (e) Plan view of corner with ties to at least 4 witness monuments. If in disagreement with previously established corner, show the distances between the two corners and also indicate the ties to the disputed corner.

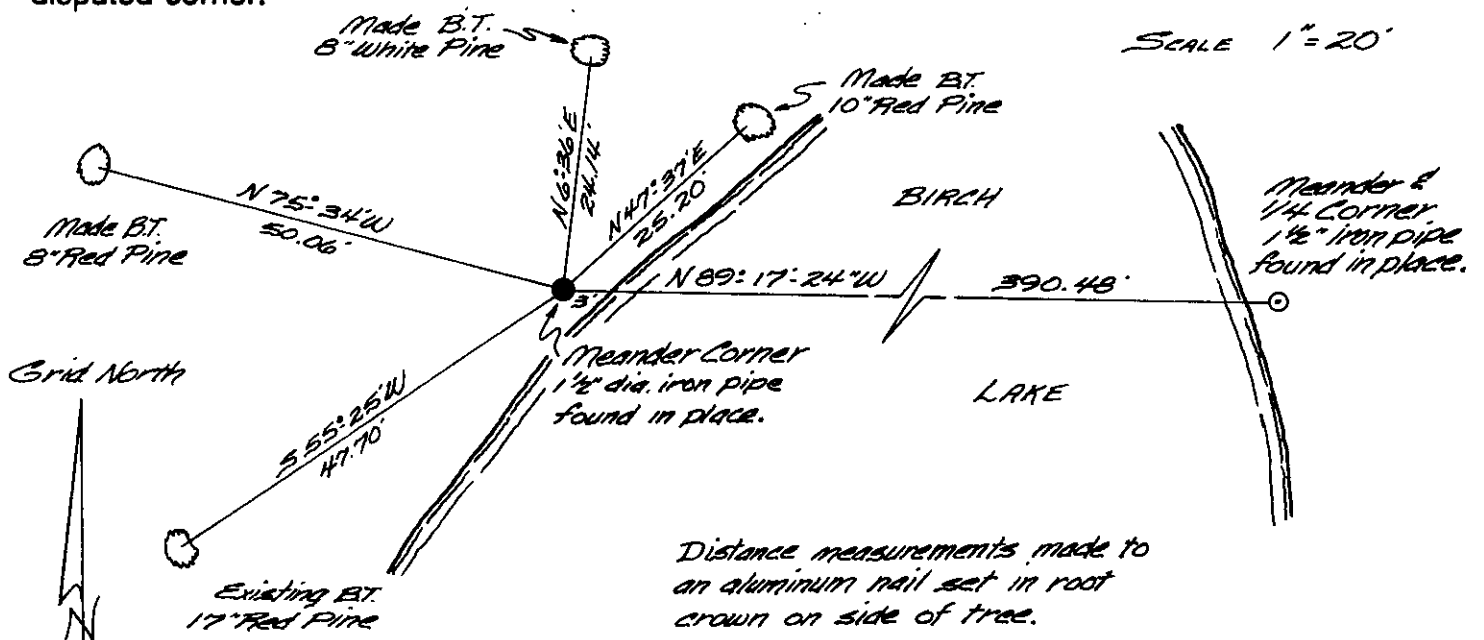

(i) I, James D. Rein, Reg. Land Surveyor No. S-1234
 (type or print name) certify that the corner location on this record
 was determined by me or under my direction and control and that
 this U.S. Public Land Survey Monument Record is correct and
 complete to the best of my knowledge and belief.

James D. Rein Signature
 October 19, 1985 Date

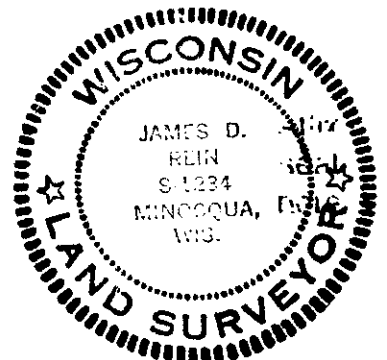

Index No. S-23


3608120023

U.S. PUBLIC LAND SURVEY MONUMENT RECORD

Note: This form is intended and designed to fulfill all requirements of Wisconsin Administrative Code, Chapter A-E 7.08 U.S. Public Land Survey Monument Record (3)(a-i).

(a) CORNER LOCATION
 Meander Cor. of Secs. 12 & 13
 Township 36 North
 Range 8 East of the 4th P.M.
 Town of Crescent
 County of Oneida

WISCRS - Oneida County
 N: 155,655.92 USft
 E: 256,872.50 USft
 Datum: NAD 83(2011) ep. 2010.00
 GNSS Method: RTN - Offset
 GNSS Control: WISCORS VRS

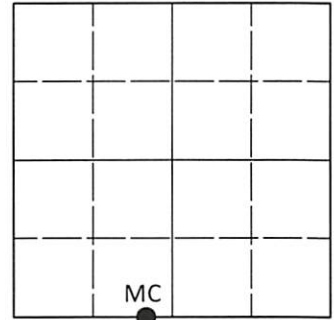

Sec. 12, T. 36 N., R. 8 E.

(b)(f)(g)(h) Description of monument found at this corner and if it was accepted, state all evidence (material, testimonial, occupational, plats, records, other monuments) used as a basis for accepting. If not accepted or if nothing was found, state evidence used as basis for establishing location. If re-established through lost corner proportionate methods, indicate all monuments, distances and directions used to establish. Indicate type of monument and sign post found or set.

This record is a perpetuation of the following land corner document(s):


October 19, 1985: USPLS Monument Record by James D. Rein, filed in Oneida County

A complete history of the corner can be found on the previous land corner document(s). I accept the record activity as a true and faithful perpetuation or reestablishment of the original corner location and further perpetuate it as described below.

July 6, 2022: I found and accepted the record monument, a 1.8" o.d. iron pipe rusted off at grade. As it's grown into the roots of a nearby tree, I was unable to remove the pipe. Inside the pipe, I drove a 1.0" diam., 30" long aluminum pipe with a 2.5" diam. Oneida Co. aluminum cap projecting 3" above a ring of stone. I found or established accessories as indicated below. I set a white vinyl sign post bearing Northwest, 1 ft. ±

The coordinate value shown has been determined by traversing from two or more GNSS offset points satisfying the accuracy requirements defined and qualified in the 2022 Oneida County Fee Schedule for USPLS Corners.

(c)(d)(e) Plan view of corner with ties to at least 4 witness monuments. If in disagreement with previously established corner, show the distances between the two corners and also indicate the ties to the disputed.

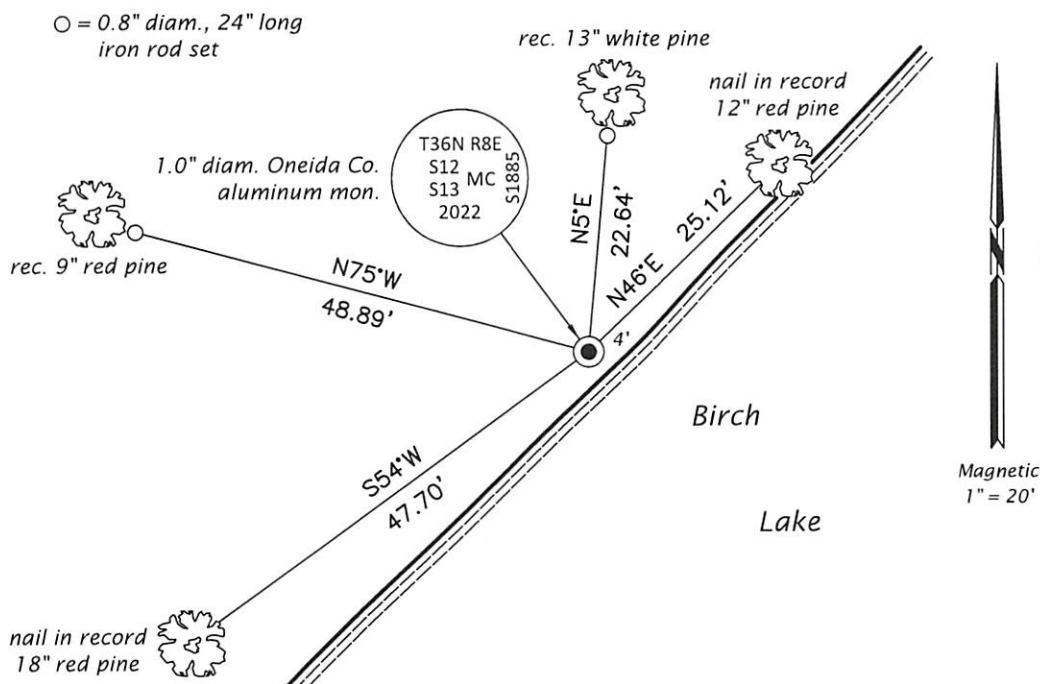

REGISTER OF DEEDS OFFICE
 ONEIDA COUNTY
 FILED

AUG 31 2022

KYLE J. FRANSON
 REGISTER OF DEEDS

(i) I, Jeffrey W. Austin, Professional Land Surveyor No. S-1885, hereby certify that the corner location on this record was determined by me or under my direction and control and that this U.S. Public Land Survey Monument Record is correct and complete to the best of my knowledge and belief.

 Signature Date