

CERTIFIED LAND CORNER RESTORATION

State of Wisconsin }
County of Oneida } ss.

I William Immich, do hereby certify that on the 13th day of Dec., 19 81, I found evidence of the West 1/4 corner corner of Section 13 Township 36 North, Range 8 East, Fourth Principal Meridian, as described hereon; and that from this evidence I established a new monument and accessories as described hereon to perpetuate the original location of this corner:

Description of original monument and accessories and subsequent restorations:

William Daugherty Government Surveyor 1863

North between 13 & 14 40.00 set 1/4 post Tam. 12 N 80 E 18
Birch 7 N 51 1/2 W 9

1894 B.F. Dorr subdivided Section 13

1957 H. Moore set 1/16 corner south of 1/4 corner

1979 D. Stella tied survey to corner

1979 R. Boniville tied Certified Survey in Section 14 to corner
calls for iron pipe.

Description of corner evidence found:

1979 W. Immich subdivided Section 13 found 3/4" iron pipe fit Dorrs section subdivision good, tied to 1/16 corner south fit Moore and Boniville distance of 1320 good.

Description of monument and accessories I established to perpetuate the location of this corner:

found 3/4" iron pipe replaced with aluminum county marker stamped as shown. Corner falls in east edge of swamp from Wisconsin River fence line running east pipe at corner of fence.

made new b.t. cedar 4" N 80 E 3.95'
cedar 5" N 3 E 43.12'
spruce 7" S 34 W 41.57'
left bank Wisconsin River West 186'

T 36 N

S 14 * S 13

R 8 E

S - 1383



Corner data checked with record & accepted as correct by Robert H. Stewart, Oneida County Surveyor

Resident witnesses.....

Dated at Rhinelanders Wisconsin, this 13 day of Dec. 19 81.


Signature William Immich Title R.L.S.
(County Surveyor, Registered Land Surveyor, or other duly authorized official)

Surveyors Registration No. 1383

Office of Oneida County of Oneida

I hereby certify that the within instrument was filed in this office for record on the 25th day of August 19 82 and was filed in Book No. _____ Page No. _____ of County Records.

Signature Doris Verage Kuehn Title Register of Deeds

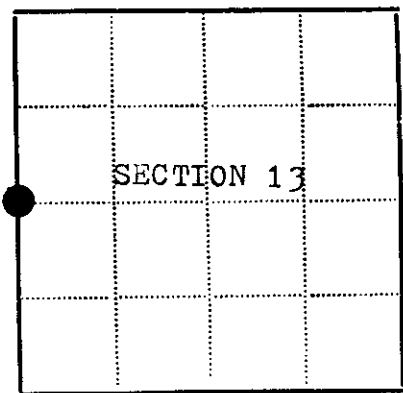

● - Corner monument restored
□ -

Township _____, Range _____, Section _____, Index No. _____, Page No. _____

3608142000

12-7