


U.S. PUBLIC LAND SURVEY MONUMENT RECORD

Note: This form is intended and designed to fulfill all requirements of Wisconsin Administrative Code, Chapter A-E 5.02, U.S. Public Land Survey Monument Record (3) (a) (b) (c) (d) (e) (f) (g) (h) (i). An additional sheet may be added if necessary to conform with said requirements.

(a) Corner location: Township 36 North
 Range 8 East/West

Town/City/Village Crescent

County Oneida

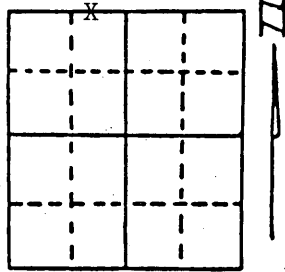

Section 22


(b) (f) (g) (h) Description of monument found at this corner and if it was accepted, state all evidence (material, testimonial, occupational, plats, records, other monuments) used as a basis for accepting. If not accepted or if nothing was found, state evidence used as basis for establishing location. If reestablished through lost corner proportionate methods, indicate all monuments, distances and directions used to establish.

- 1863 - Wm. Daugherty established this corner on west shore of lake and set wood post. White Pine, N62°W, 29 1/2 links
- 1900 - Vaughan perpetuated this corner from remains of original BT.
- 1946 - Lytle perpetuated this corner and made new BT, 25" White Pine, S61°W, 6 links.
- 1974 - GLO found Lytles BT and set a 2 1/2" x 30" iron pipe with brass cap and made two BTs:
 12" Hemlock, S24°W, 56 links (36.96') 11" White Pine, N69°W, 64 links (42.24')
- 1988 - Milo E. Stefan found GLO monument for M.C. in excellent condition with BTs:
 25" White Pine Snag, S69°W, 3.96'
 14" White Pine, S24°W, 39.45' *NOTE different species and distance in error
 11" White Pine, N69°W, 42.59'

(c) (d) (e) Plan view of corner with ties to at least 4 witness monuments. If in disagreement with previously established corner, show the distances between the two corners and also indicate the ties to the disputed corner.

- 1 - GLO brass cap on 2 1/2" iron pipe
- 2 - 16" Hemlock, South, 27.35'
- 3 - 14" White Pine, S24°W, 39.45'
- 4 - 12" White Pine, S88°W, 25.31'
- 5 - 12" White Pine, N69°W, 42.59'
- 6 - Plastic Sign Post, South, 2.1'

Note: BTs distances to nail in side of trees.
 BTs scribed "MC SxxBT"

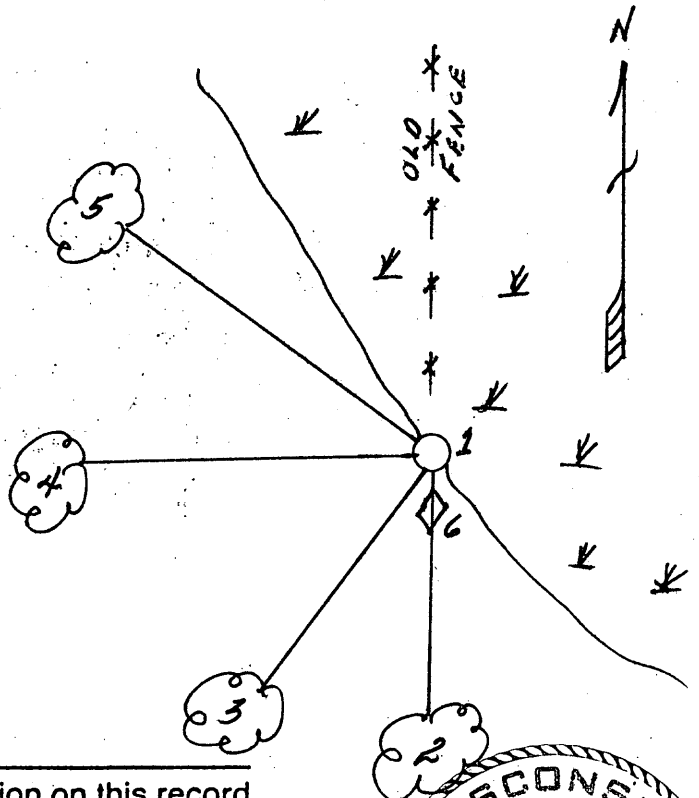

(i) I, Milo E. Stefan
 (type or print name) certify that the corner location on this record was determined by me or under my direction and control and that this U.S. Public Land Survey Monument Record is correct and complete to the best of my knowledge and belief.

Milo E. Stefan
 Signature

1/4/89
 Date



Index No-N-15

3608/50021

REGISTER OF DEEDS OFFICE
ONEIDA COUNTY, WIS.

FILED
JAN 12 1989

At _____ O'Clock _____ M
THOMAS H. LEIGHTON
REGISTER OF DEEDS