

U. S. PUBLIC LAND SURVEY RECORD


NOTE: This form is intended and designed to fulfill all requirements of Wisconsin Administrative Code, Chapter AE-7.08 U.S. Public Land Survey Record (3) (a) (b) (c) (d) (e) (f) (g) (h) (i). An additional sheet may be added if necessary to conform with said requirements.

(a) CORNER LOCATION:

State Plane Coordinates

M.C. Corner of Sec. 17
 Township 36 North
 Range 8 East
 Town/City Woodboro

X N/A
 Y N/A
 Datum Base N/A
 County of Oneida

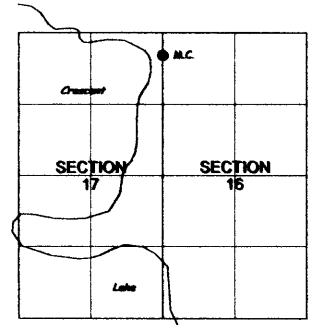

(b) HISTORY OF ORIGINAL CORNER ESTABLISHMENT


Original Surveyor: Wm. E. Daugherty Original B.T.'S 15" Aspen, N 68° E, 4 lks.
 Date of Survey: Commenced July, 1863 10" W. Pine, N 83° W, 18 lks.
 Completed July, 1863

(b) (f) (g) (h) Description of monument found at this corner and if it was accepted, state all evidence (material, testimony, occupational, plats, records or other monuments) used as a basis for accepting. If not accepted or if nothing was found, state evidence used for establishing location. If re-established through lost corner proportionate methods, indicate all monuments, distances and directions used to establish. Indicate type of monument and sign post found or set.

1939 - As part of Dependent Resurvey & Ext. Survey of Sec's. 16 & 21 by U.S.G.L.O., original corner evidence was recovered by Hal D. Craig. He perpetuated corner from original W. Pine stump with brass capped iron post; made new B.T.'s - 10" Norway Pine, S 46½° E, 28 lks (18.48') and 11' Norway Pine, S 88¼° W, 40 lks (26.40').


2004 - I recovered the G.L.O.'s brass capped iron pipe as evidenced by their two B.T.'s still existing and in proper relation to corner. The corner lies in adjacent land owners yard. I further perpetuated this corner as shown below.

(c) (d) (e) Plan view of corner with ties to at least 4 witnesses monuments. if in disagreement with previously established corner, show the distances between the two corners and also indicate the ties to the disputed.

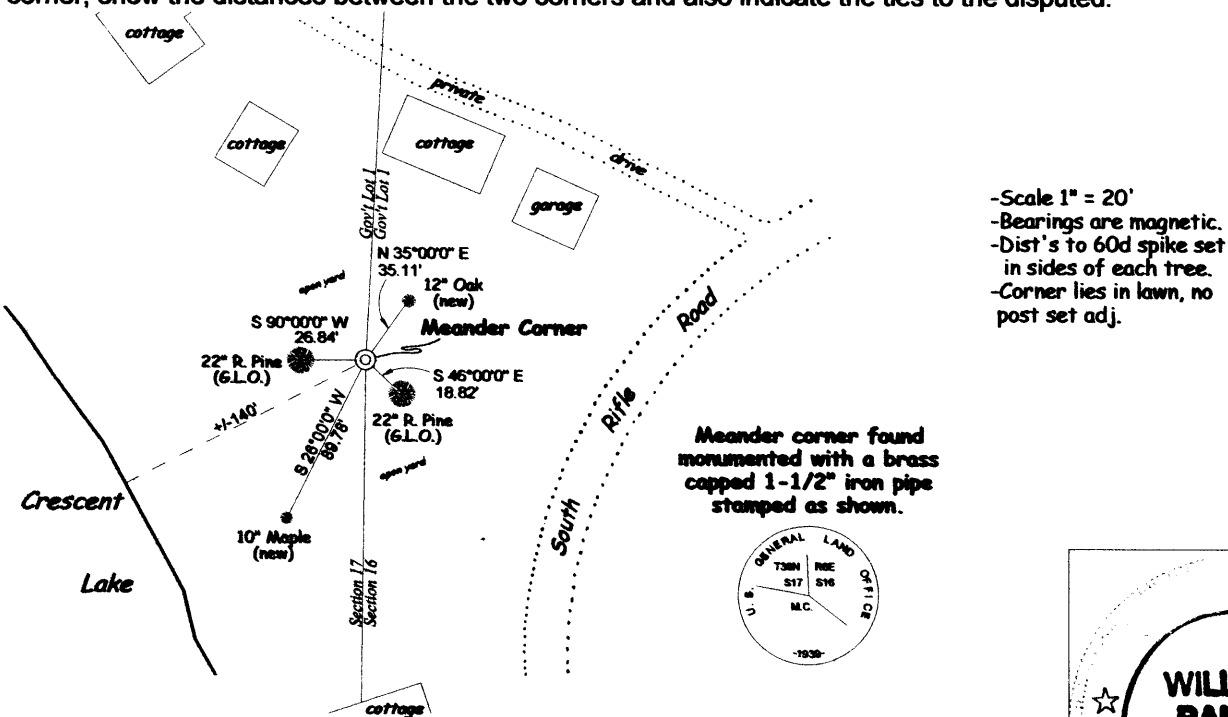

(i) I, William E Bandow, hereby certify that the corner location on this record was determined by me or under my direction and control and that this U.S. Public Land Survey Monument Record is correct and complete to the best of my knowledge and belief.

William E Bandow 12-17-04
 Signature Date

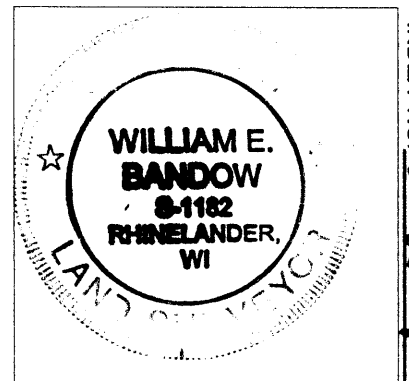

INDEX NO. 5-K 9

3608173800