


# U.S. PUBLIC LAND SURVEY MONUMENT RECORD

**Note:** This form is intended and designed to fulfill all requirements of Wisconsin Administrative Code, Chapter A-E 7.08 U.S. Public Land Survey Monument Record (3) (a) (b) (c) (d) (e) (f) (g) (h) (i). An additional sheet may be added if necessary to conform with said requirements.

(a) Corner location: Township 36 North  
 Range 8 East/West

Town/City/Village Crescent

County Oneida

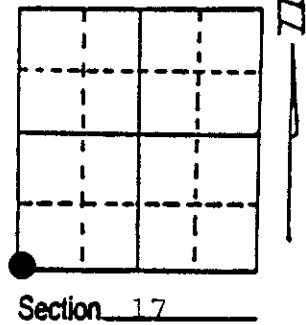

(b) (f) (g) (h) Description of monument found at this corner and if it was accepted, state all evidence (material, testimonial, occupational, plats, records, other monuments) used as a basis for accepting. If not accepted or if nothing was found, state evidence used as basis for establishing location. If reestablished through lost corner proportionate methods, indicate all monuments, distances and directions used to establish. Indicate type of monument found or set and sign post.

- 1863 William Daugherty set Post Tam 8" S 74 W 32 lks. Tam 6" S 54 E 39 lks.
- 1920 Vaughan found original stumps New BT's W. Pine 12" N 51½ E 37¼ lks. W. Pine 15" N 34 W 45½ lks.
- 1939 G.L.O. set concrete mon. with brass plate marked to identify corner remains of original trees Tam. stump rotted to the ground S 50 E 40 lks. Rotted Tam. stump 6" N 71 W 33 lks. Local BT's by Vaughan, burned W. Pine stump 16" N 53½ E 36 lks. W. Pine stp 20" N 34½ W 45 lks. Old fence corner Post 8" S 1 lk. No new trees available.
- 1989 William Bandow found monument in place set white plastic Post E 1' fence Post N 1' referenced the corner as shown below.


(c) (d) (e) Plan view of corner with ties to at least 4 witness monuments. If in disagreement with previously established corner, show the distances between the two corners and also indicate the ties to the disputed corner.

NOTE:

MEASUREMENTS TAKEN FROM  
6" SPIKE IN SIDE OF TREE

BEARINGS TAKEN WITH  
HANDHELD MAGNETIC  
COMPASS

NO SCALE

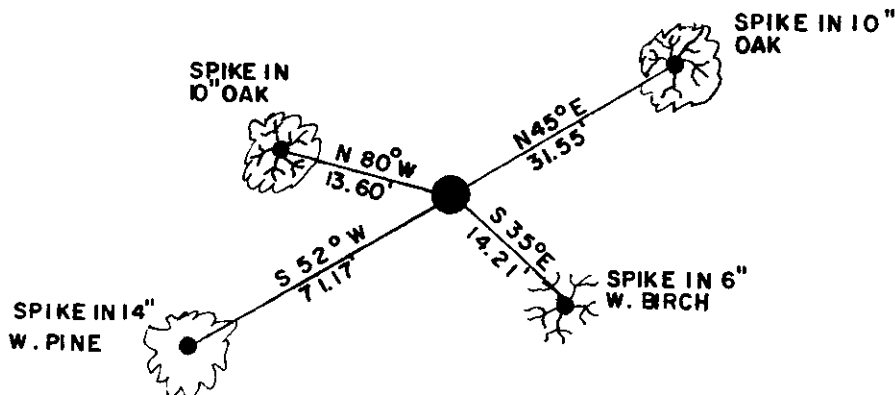

(i) I, William E. Bandow  
 (type or print name) certify that the corner location on this record was determined by me or under my direction and control and that this U.S. Public Land Survey Monument Record is correct and complete to the best of my knowledge and belief.



William E. Bandow                      12-29-89  
 Signature                                      Date

Index No. N-5

3608/80000