

This form is intended to fulfill the requirements of Chapter A-E 7.08 (3)(a) thru (i) U.S. Public Land Survey Monument Location Record, Wisconsin Administrative Code. Use the reverse side of form for continuation.

U.S. PUBLIC LAND SURVEY MONUMENT LOCATION RECORD

USPLS CORNER: SOUTH WITNESS MC SECTION: 17 TOWNSHIP: 36 NORTH RANGE: 8 EAST

NAME OF WATERWAY FOR M.C. CORNER : CRESCENT LAKE SECTION LINE: WEST

(CITY)(VILLAGE)(TOWN) OF: CRESCENT COUNTY OF: ONEIDA

Description of monument found or placed and all other evidence used as the basis for monument location; including monuments and related measurements required if the corner location was reestablished by lost corner proportionate methods. Also indicate name of original surveyor, original survey date and the corner monument, bearing trees, witness or other reference monuments established; including measured bearing and distance ties, from available records.


Found and accepted an unrecorded standard 2" dia. aluminum pipe monument with Oneida County cap 8" up as stamped by Todd Loftus/RLS 1523 on unknown date and also found a standard white poly 'T' marker post 14" South of the corner monument; corner falls 4' South of lake shoreline bearing S50°E this date and an old fenceline leads South up steep slope to Lair Drive.

In July 1863, William E. Daugherty/GLO set a wood post as original corner and marked OBTs: a 20" Pw S80°W 5 links and a 10" Bw S10°E 17 links; all are now obliterated. In March 1927, George S. Johnston/Civil Engineer notes a stake at this MC per old plat of Zahn-Kelly-Jewell Lots of Govt Lot 6 in Section 17 per Oneida County records.

During a GLO Resurvey in 1939, per field notes filed as L-863 in Oneida County survey records, Cadastral Surveyors Hal D. Craig and Lester S. Mann note a rotted stake found at the original GLO survey MC location on old 2' high lake bank bearing N60°W/S60°E about 69' South of new lakeshore, and OBT as 26" Pw stump S80°W 5 links and a later 18" PW stump BT S38.5°E 17 links. No new wood post, iron or concrete monument was reset at the MC corner by the GLO Resurvey, nor newer BTs noted, which is considered very irresponsible by this surveyor as all of the foregoing corner evidence is now obliterated beyond usage!

In June 1961, Sy M. Poskie/RLS 140 shows this corner by a probable iron pipe or wood post circle symbol per Plat of Survey filed as B-1905 in Oneida County survey records; no BTs were noted. In 1986 and 1992, Todd J. Loftus/RLS 1523 shows this corner as a 1" iron pipe per Plats of Survey filed as L-351 and B-2736 in Oneida County survey records.

Plan view map of monument location with bearing and distance ties to a minimum of four(4) described witness or reference monuments of concrete, natural stone, iron, live bearing trees or equivalent material. If applicable, also show a minimum of two(2) bearing and distance ties to any other monument found and not accepted; including the bearing and distance from the accepted monument.

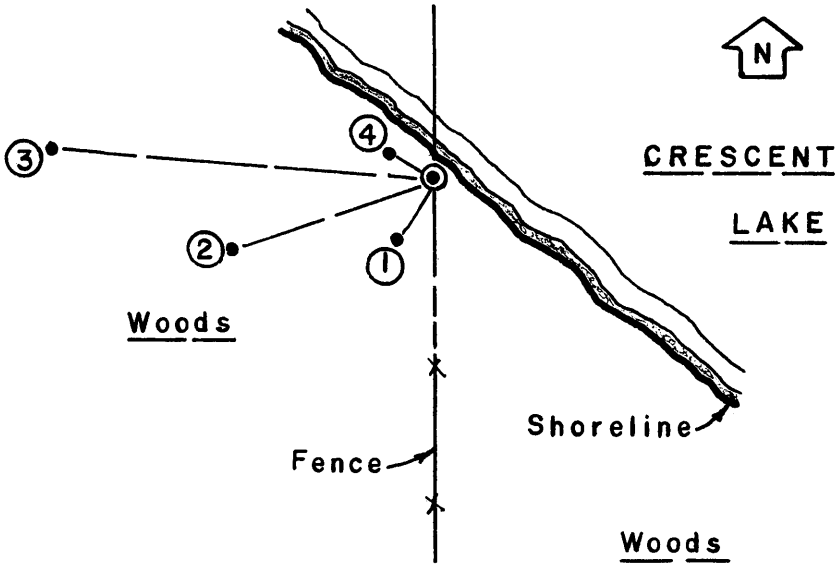

- WITNESS MONUMENT TIES:**
- ① New 4.5" Mr BT S34°W 13.79'.
 - ② New 9" Mr BT S72°W 44.18'.
 - ③ New 7" Mr BT N85°W 79.38'.
 - ④ Old BT N57°W 11.23' with old 60d spike in lower right face; new ties are to new PK/W in right face.
- No other older BTs or corner evidence observed in nearby wooded area. An improved lake frontage lot is SE of corner. This recovery completed November 21, 2002; there were no direct witnesses.

SCALE: 1" = 40'

Unless otherwise indicated, all bearing tree ties are to a .25" dia. by 2.5" long PK nail with a 1.25" dia. steel washer driven into unblazed right face and a .25" dia. by 2.5" long PK nail with a 2" dia. steel washer stamped BT is also driven into unblazed face of bearing tree at DBH; the basis for measured bearings is by compass to nearest degree and all tie distances are measured horizontal by steel tape corrected to nearest 1/100th feet at standard temperature of 68° F.

RLS SEAL:



LAND SURVEYOR CERTIFICATE:

I, William C. Rohde, hereby certify that I am duly licensed as a Professional Land Surveyor in the State of Wisconsin; that this USPLS monument location was determined by me and/or under my direct supervision and control; and that this U.S. Public Land Survey Monument Location Record is true and correct to the best of my knowledge and belief.

Signed: *William C. Rohde*
 William C. Rohde RLS 841

	T36N		
	17		
	R8E		

Date Signed: March 1, 2003

SECTION LOCATION MAP
 INDEX NO. M N 5

3608 180600