

This form is intended to fulfill the requirements of Chapter A-E 7.08 (3)(a) thru (i) U.S. Public Land Survey Monument Location Record, Wisconsin Administrative Code. Use the reverse side of form for continuation.

U.S. PUBLIC LAND SURVEY MONUMENT LOCATION

Recorders Data

USPLS CORNER: SOUTH MC AND WC SECTION: 17 TOWNSHIP: 36 NORTH RANGE: 08 EAST

NAME OF WATERWAY FOR M.C. CORNER: CRESCENT LAKE SECTION LINE: WEST

(CITY/VILLAGE/TOWN) OF: CRESCENT COUNTY OF: ONEIDA

Description of monument found or placed and all other evidence used as the basis for monument location; including monuments and related measurements required if the corner location was reestablished by lost corner proportionate methods. Also indicate name of original surveyor, original survey date and the corner monument, bearing trees, witness or other reference monuments established; including measured bearing and distance ties, from available records.


Found and accepted a standard 6" dia. concrete monument with stamped GLO brass tablet in top at 2"± below grade on a steep slope down to south shore of Crescent Lake. Due to bank erosion, the monument had tipped North down the bank, so I carefully excavated to its base imprint in sub-soil, which also revealed the original plumb soil socket, and I tipped the monument South and re-plumbed with tamped backfill to secure for new ties.

In July 1863, William E. Daugherty/GLO set a wood post as the original MC/Wit Corner at 1.30 chains South of the NW corner of Section 17 in lake and marked OBTs: An 8" Hemlock S73°W 5 links and a 12" Hemlock N69°W 9 links; all of which are now obliterated.

In 1939, during a GLO resurvey, Craig and Mann found and accepted a 1" iron pipe at this corner location, from which they found the SW OBT as a stump and the NW OBT as a live 14" Hemlock with plain scribing in its face blaze at S69°E 9 links, and they reset the iron pipe at the corner with a standard 6" dia. by 24" long concrete post with stamped GLO brass tablet in top and noted a local BT 10" Hemlock stump S73°W 5 links, now gone, and they scribed new BTs: An 8" Hemlock S57°E 10 links I found OK and used for new ties; and a 10" Hemlock N78°W 70 links, now obliterated. See GLO resurvey field notes filed as L-863 in Oneida County survey records.


In 1940, Maine notes the GLO brass cap in concrete post at this corner per Plat of Survey filed as A-118 in Oneida County survey records. This recovery was completed and witnessed by both adjoining owners on July 4, 2000.

Plan view map of monument location with bearing and distance from the accepted monument. If applicable, also show a minimum of two (2) bearing and distance ties to any other monument of concrete, natural stone, iron, live bearing trees or equivalent material. If applicable, also show a minimum of four (4) described witness or reference monuments of concrete, natural stone, iron, live bearing trees or equivalent material. If applicable, also show a minimum of two (2) bearing and distance ties to any other monument found and not accepted; including the bearing and distance from the accepted monument.

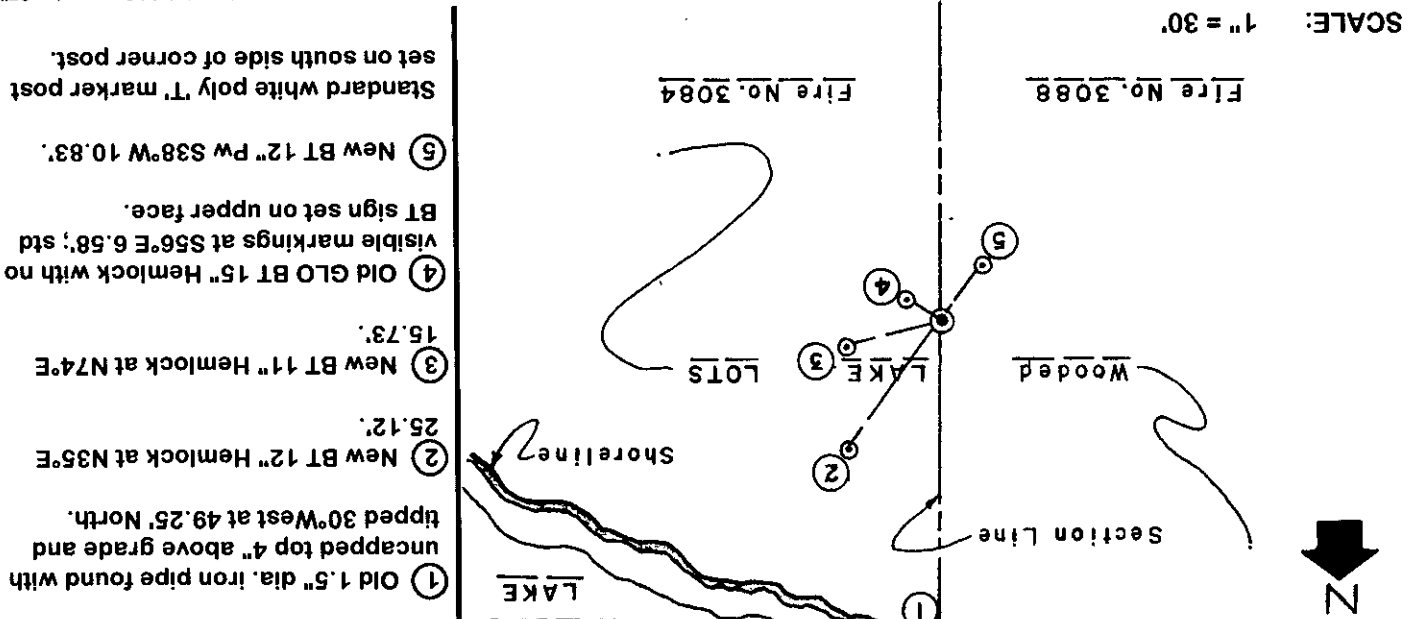

Unless otherwise indicated, all bearing trees are to a .25" dia. by 2.5" long PK nail with a 1.25" dia. steel washer driven into unblazed right face and a .25" dia. by 2.5" long PK nail with a 2" dia. steel washer stamped BT is also driven into unblazed face of bearing tree at DBH; the basis for measured bearings is by compass to nearest degree and all the distances are measured horizontal by steel tape corrected to nearest 1/100th feet at standard temperature of 68° F.

RLS SEAL:

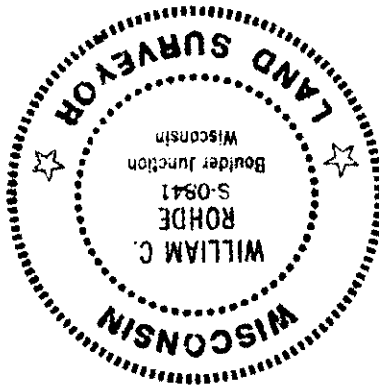

LAND SURVEYOR CERTIFICATE:

I, William C. Rohde, hereby certify that I am duly licensed as a Professional Land Surveyor in the State of Wisconsin; that this USPLS monument location was determined by me and/or under my direct supervision and control; and that this U.S. Public Land Survey Monument Location Record is true and correct to the best of my knowledge and belief.

Signed: *William C. Rohde*
William C. Rohde
RLS 841

Date Signed: January 31, 2001

SHEET 1 OF 1
FORM REVISED: 06/01/99

SECTION LOCATION MAP

		ROBE	
		17	
		T 36N	

INDEX NO. 3608183900

5
4