


# U.S. PUBLIC LAND SURVEY MONUMENT RECORD

**Note:** This form is intended and designed to fulfill all requirements of Wisconsin Administrative Code, Chapter A-E 7.08 U.S. Public Land Survey Monument Record (3) (a) (b) (c) (d) (e) (f) (g) (h) (i). An additional sheet may be added if necessary to conform with said requirements.

(a) Corner location: Township 36 North  
 Range 8 East/West  
 Town/City/Village Crescent  
 County Oneida

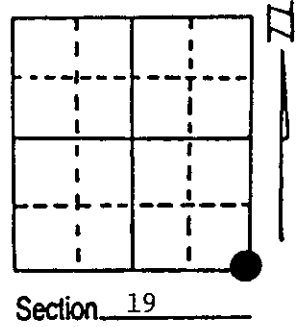

(b) (f) (g) (h) Description of monument found at this corner and if it was accepted, state all evidence (material, testimonial, occupational, plats, records, other monuments) used as a basis for accepting. If not accepted or if nothing was found, state evidence used as basis for establishing location. If reestablished through lost corner proportionate methods, indicate all monuments, distances and directions used to establish. Indicate type of monument found or set and sign post.

1863 - William Daugherty established this corner and set a wood post and made two BTs:  
 12" W. Pine, S36°W, 10 Links      10" White Pine, N56°E, 13 Links


1900's - Dorr made two BTs:  
 W. Pine Stump, N79°E, 13 Links      16" W. Pine Stump, S2°W, 32 Links

1939 - GLO Dependent Resurvey restored this corner and placed a 6" x 24" concrete cylinder with brass cap and BTs:  
 6" Red Pine, S33°E, 42 Links      6" W. Pine, S45°W, 89 Links  
 8" W. Pine, N80°W, 165 Links

7/28/89 - Milo E. Stefan found GLO monument with one 1939 BT remaining:  
 10" W. Pine, S45°W, 58.74'  
 We made four new BTs and set plastic sign post.

(c) (d) (e) Plan view of corner with ties to at least 4 witness monuments. If in disagreement with previously established corner, show the distances between the two corners and also indicate the ties to the disputed corner.

- 1) 6" x 24" Brass Cap in concrete cylinder
- 2) 8" White Birch, N30°E, 23.96'
- 3) 14" Red Pine, S43°E, 57.46'
- 4) 16" White Pine, S13°E, 19.36'
- 5) 10" Red Pine, N77°W, 111.84'
- \*6) 10" White Pine, S45°W, 58.74'
- 7) Plastic sign post, East, .7'

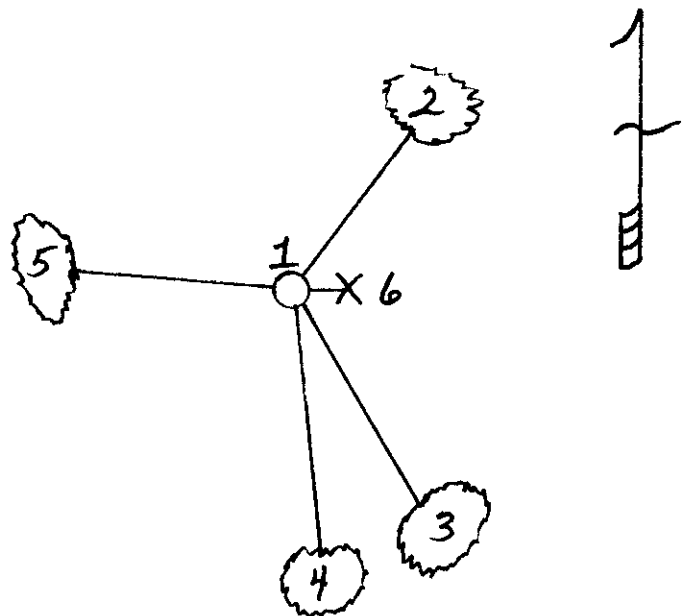

\*1939 GLO BT - not rescribed.  
 Distances to nail in side of BTs.  
 BTs scribed "BT" in stump blaze.

(i) I, Milo E. Stefan  
 (type or print name) certify that the corner location on this record was determined by me or under my direction and control and that this U.S. Public Land Survey Monument Record is correct and complete to the best of my knowledge and belief.

Milo E. Stefan  
 Signature

8/5/89  
 Date



Index No R-5

3608190000