


# U.S. PUBLIC LAND SURVEY MONUMENT RECORD

Note: This form is intended and designed to fulfill all requirements of Wisconsin Administrative Code, Chapter A-E 7.08 U.S. Public Land Survey Monument Record (3) (a) (b) (c) (d) (e) (f) (g) (h) (i). An additional sheet may be added if necessary to conform with said requirements.

(a) Corner location: Township 36 North  
 Range 8 East  
 Town/City/Village Crescent  
 County Oneida

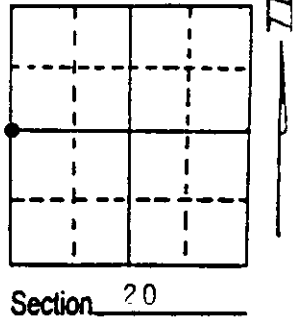

(b) (f) (g) (h) Description of monument found at this corner and if it was accepted, state all evidence (material, testimonial, occupational, plats, records, other monuments) used as a basis for accepting. If not accepted or if nothing was found, state evidence used as basis for establishing location. If reestablished through lost corner proportionate methods, indicate all monuments, distances and directions used to establish. Indicate type of monument found or set and sign post.


1863-William Daugherty set post 18" Jack Pine S 55 degrees East  
 16 links 6" Maple S 71 degrees West 19 links

1939-GLO (Hal Craig) found 1½" I.P. set 6" diameter concrete monument with brass tablet marked 19/20 12" Norway  
 N 34 degrees East 54 links marked ¼ S 20 BT. 10" White Pine  
 N 76 degrees West 48 links marked ¼ S 19 BT.

1965-Genisot found GLO Monument

1993-William E. Bandow found GLO Monument and witnessed as shown below


(c) (d) (e) Plan view of corner with ties to at least 4 witness monuments. If in disagreement with previously established corner, show the distances between the two corners and also indicate the ties to the disputed corner.

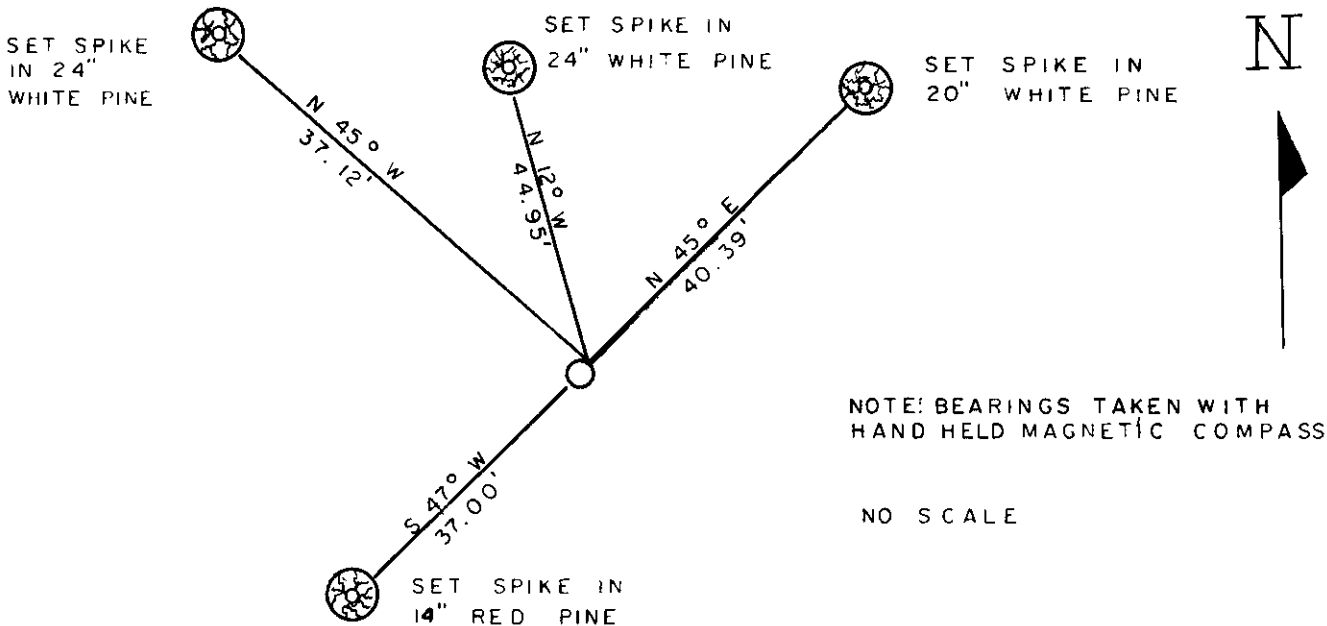

NOTE: BEARINGS TAKEN WITH HAND HELD MAGNETIC COMPASS  
 NO SCALE

(i) I, William E. Bandow  
 (type or print name) certify that the corner location on this record was determined by me or under my direction and control and that this U.S. Public Land Survey Monument Record is correct and complete to the best of my knowledge and belief.

William E. Bandow 3-11-97  
 Signature Date

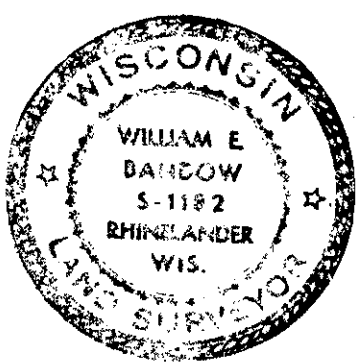

Stamp

Index No. P-5