

At \_\_\_\_\_ O'Clock \_\_\_\_\_ M

This form is intended to fulfill the requirements of Chapter A-Er.08 (3)(a) and (b) of the Public Land Survey Monument Location Record, Wisconsin Administrative Code. Use the reverse side of form for continuation.

**U.S. PUBLIC LAND SURVEY MONUMENT LOCATION RECORD**

Recorders Data

USPLS CORNER: SOUTH WITNESS MC SECTION: 21 TOWNSHIP: 36 NORTH RANGE: 8 EAST  
 NAME OF WATERWAY FOR M.C. CORNER: CRESCENT LAKE SECTION LINE: WEST  
 (CITY)(VILLAGE)(TOWN) OF: CRESCENT COUNTY OF: ONEIDA

Description of monument found or placed and all other evidence used as the basis for monument location; including monuments and measurements required if the corner location was reestablished by lost corner proportionate methods. Also indicate name of the original surveyor, original survey date and the corner monument, bearing trees, witness or other reference monuments established, including measured bearing and distance ties, from available survey records.


In July 1863, William E. Daugherty/GLO set a wood post as original MC and noted OBTs: a 7" Bw S06°W 12 links and an 8" Hemlock S34°E 18 links; all now obliterated.

In September/October 1939, during a GLO Resurvey, Hal D. Craig, established this Witness MC location and set a 6" dia. x 24" long concrete monument, 22 inches into the ground, with a 3.5" dia. GLO brass tablet imbedded in top in a cleared field 1 chain South of Crescent Lake shoreline, and noted new blazed and scribed BTs: a 6" Mr S77°E 152 links and a 12" Mr S46°W 250 links; both now obliterated. See Pages 10 and 11 of GLO field notes filed as L-863L in Oneida County survey records.

In November 1949, Forrest R. Wincentsen/RLS 155, notes a GLO monument at this Witness MC per Page 63 of Wincentsen Book 1 filed in Oneida County survey records. In December 1950, he also notes this Witness MC location per his Plat of Survey filed as B-649 in Oneida County survey records. In October, 1962, Joseph C. Kirby/RLS 253, notes a GLO monument at this Witness MC per his Plat of Survey filed as B-676 in Oneida County survey records.

On June 15, 2006 I found the 6" dia. GLO concrete monument with fractured top and brass tablet missing flush with existing open field grade and I drove a 3/8" dia. x 2.75" long spike with 1" dia. cap embossed "Survey Mark" into old brass tablet stem hole in top of the concrete monument which I painted fluorescent orange. Corner falls S65°W 46'+/- from the Crescent Lake shoreline bearing N40°W+/- . There were no direct witnesses.

Plan view map of monument location with bearing and distance ties to a minimum of four(4) described witness or reference monuments of concrete, natural stone, iron, live bearing trees or equivalent material. If applicable, also show a minimum of two(2) bearing and distance ties to any other monument found and not accepted; including the bearing and distance from the accepted monument.

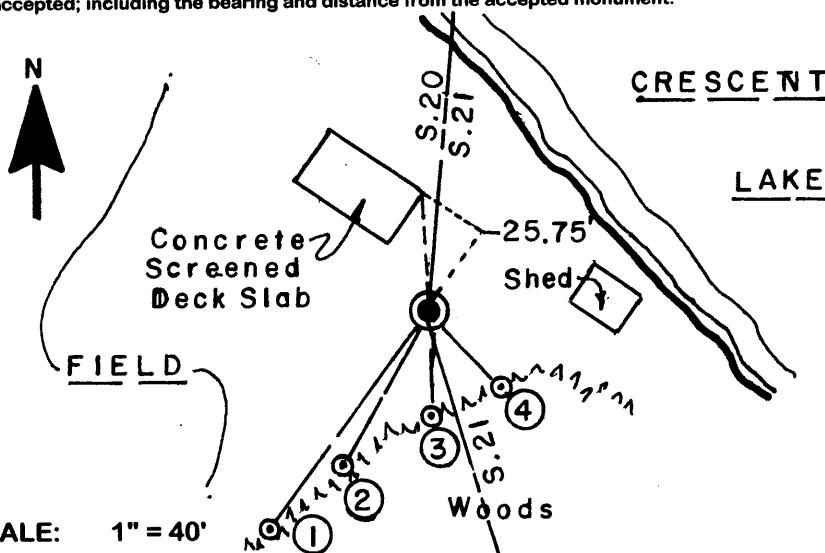


**WITNESS MONUMENT TIES:**

- ① 5/8" dia. x 24" rebar set flush S35°W 56.30' at edge of planted conifers bearing S65°W +/- along the SW edge of open field slope down to the lakeshore.
- ② Same set S30°W 35.77'.
- ③ Same set South 22.30" on North side of standard white poly 'T' post set.
- ④ Same set S46°E 22.10'.

SCALE: 1" = 40'

Unless otherwise indicated, all bearing tree ties are to a .25" dia. by 2.5" long PK nail with a 1.25" dia. steel washer driven into unblazed right face and a .25" dia. by 2.5" long PK nail with a 2" dia. steel washer stamped BT is also driven into unblazed face of bearing tree at DBH; the basis for measured bearings is by compass to nearest degree and all tie distances are measured horizontal by steel tape corrected to nearest 1/100th feet at standard temperature of 68° F.

RLS SEAL:

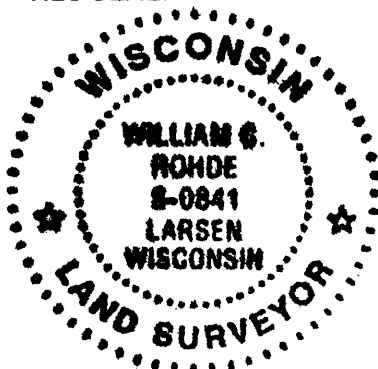

LAND SURVEYOR CERTIFICATE:

I, William C. Rohde, hereby certify that I am duly licensed as a Professional Land Surveyor in the State of Wisconsin; that this USPLS monument location was determined by me and/or under my direct supervision and control; and that this U.S. Public Land Survey Monument Location Record is true and correct to the best of my knowledge and belief.

Signed: *William C. Rohde*  
William C. Rohde RLS 841


		T 36N	
		21	
		R 8E	

# U.S. PUBLIC LAND SURVEY MONUMENT RECORD

Note: This form is intended and designed to fulfill all requirements of Wisconsin Administrative Code, Chapter A-E 7.08 U.S. Public Land Survey Monument Record (3)(a-i).

(a) CORNER LOCATION  
 Wit. Meander Cor. of Secs. 20 & 21  
 Township 36 North  
 Range 8 East of the 4th P.M.  
 Town of Crescent  
 County of Oneida

WISCRS - Oneida County  
 N: 147,541.10 USft  
 E: 238,177.03 USft  
 Datum: NAD 83(2011) ep. 2010.00  
 GNSS Method: RTN - Direct  
 GNSS Control: WISCORS VRS

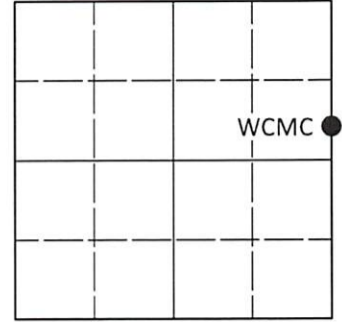

Sec. 20, T. 36 N., R. 8 E.

(b)(f)(g)(h) Description of monument found at this corner and if it was accepted, state all evidence (material, testimonial, occupational, plats, records, other monuments) used as a basis for accepting. If not accepted or if nothing was found, state evidence used as basis for establishing location. If re-established through lost corner proportionate methods, indicate all monuments, distances and directions used to establish. Indicate type of monument and sign post found or set.

*This record is a perpetuation of the following land corner document(s):*


*November 20, 2006: USPLS Monument Record by William C. Rohde, filed in Oneida County*

*A complete history of the corner can be found on the previous land corner document(s). I accept the record activity as a true and faithful perpetuation or reestablishment of the original corner location and further perpetuate it as described below.*

*May 17, 2022: I found and accepted the record monument, a "survey mark nail" in the center of a 6.0" diam. concrete monument, firmly set, flush with the ground surface. I found or established accessories as indicated below.*

*The coordinate value shown is the weighted mean of two or more GNSS observations at markedly different times satisfying the accuracy requirements defined and qualified in the 2022 Oneida County Fee Schedule for USPLS Corners.*

(c)(d)(e) Plan view of corner with ties to at least 4 witness monuments. If in disagreement with previously established corner, show the distances between the two corners and also indicate the ties to the disputed.

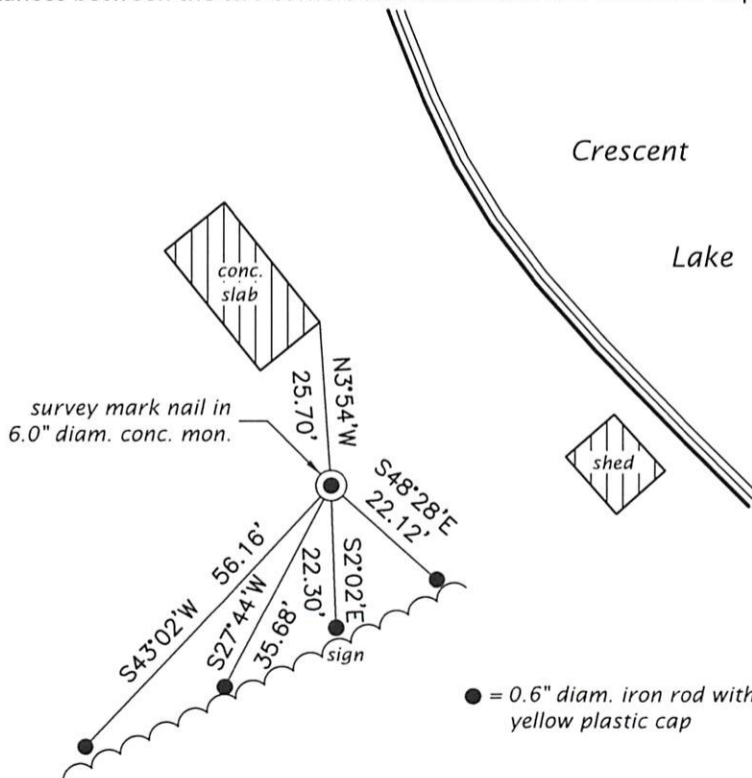


Oneida Co. Grid  
 1" = 30'

REGISTER OF DEEDS OFFICE  
 ONEIDA COUNTY  
 FILED

AUG 02 2022

KYLE J. FRANSON  
 REGISTER OF DEEDS

(i) I, Jeffrey W. Austin, Professional Land Surveyor No. S-1885, hereby certify that the corner location on this record was determined by me or under my direction and control and that this U.S. Public Land Survey Monument Record is correct and complete to the best of my knowledge and belief.

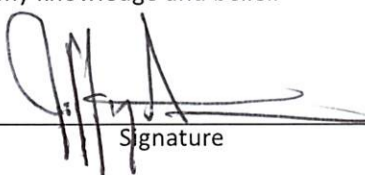  
 Signature

JUNE 1, 2022  
 Date