

U.S. PUBLIC LAND SURVEY MONUMENT RECORD


Note: This form is intended and designed to fulfill all requirements of Wisconsin Administrative Code, Chapter A-E 5.02, U.S. Public Land Survey Monument Record (3) (a) (b) (c) (d) (e) (f) (g) (h) (i). An additional sheet may be added if necessary to conform with said requirements.

(a) Corner location: Township 36 North

Range 8 East

Town: CRESCENT


County ONEIDA

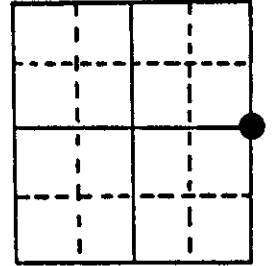


Section 21

(b) (f) (g) (h) Description of monument found at this corner and if it was accepted, state all evidence (material, testimonial, occupational, plats, records, other monuments) used as a basis for accepting. If not accepted or if nothing was found, state evidence used as basis for establishing location. If reestablished through lost corner proportionate methods, indicate all monuments, distances and directions used to establish.

FOUND G.L.O. Brass Capped Concrete Monument set by Hal D. Craig in 1939 Dependent Resurvey - SEE NOTES ON REVERSE SIDE

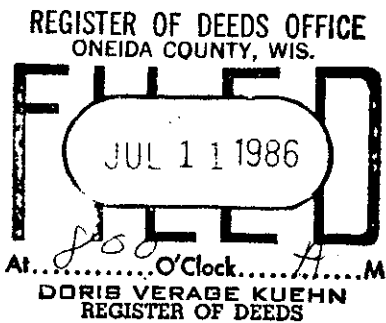

(c) (d) (e) Plan view of corner with ties to at least 4 witness monuments. If in disagreement with previously established corner, show the distances between the two corners and also indicate the ties to the disputed corner.

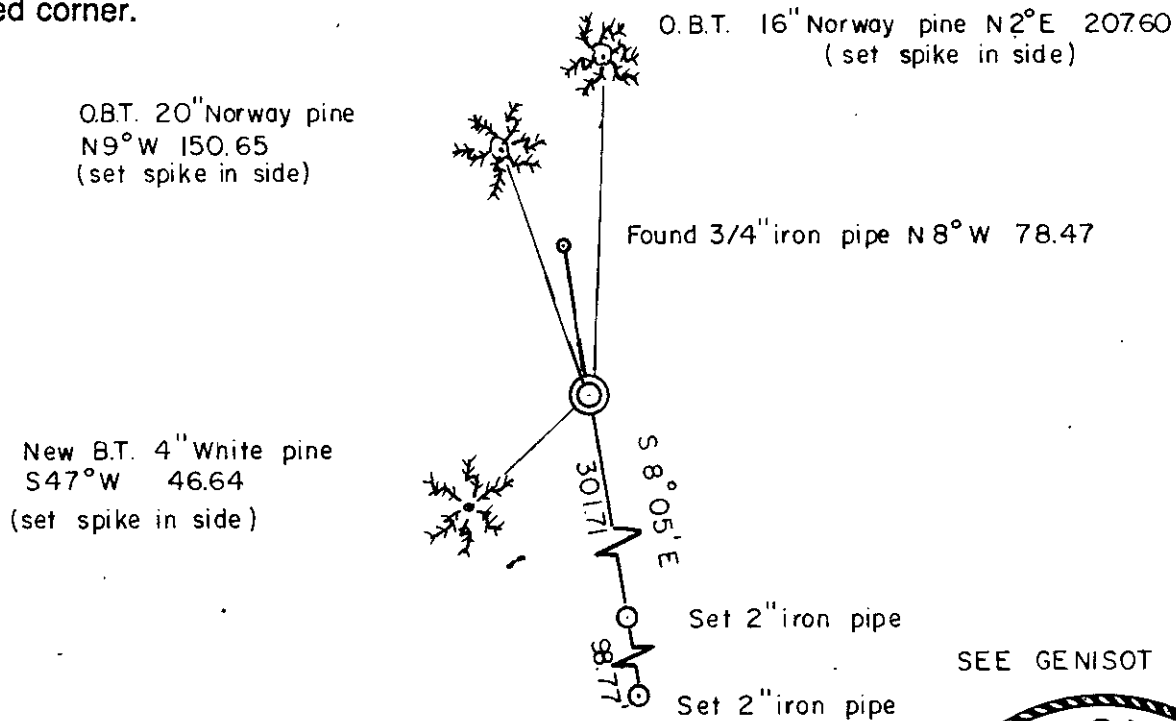

SEE GENISOT DWG, 7555

(i) I, William Immich
 (type or print name) certify that the corner location on this record was determined by me or under my direction and control and that this U.S. Public Land Survey Monument Record is correct and complete to the best of my knowledge and belief.

William Immich Signature November 8, 1984 Date



Index No. P-13

3608212000

Stock No. 26273

COPY OF HAL D. CRAIGS NOTES

S. $0^{\circ} 47'$ E., bet. secs. 21 and 22.

Over rolling land, through timber and undergrowth, along a cleared fence line.

- 2.70 Enter a tamarack and spruce swamp, bears N. 70° W. and S. 70° E.
- 20.58 Cleared fence line turns to the east, continue through swamp.
- 30.60 Leave swamp, thence over rolling land, through upland timber and undergrowth, bears E. and W.
- 39.00 Enter a burned spruce and tamarack swamp, bears NE. and SW.
- 41.30 The point for the $\frac{1}{4}$ sec. cor., at the corner of fences bearing S. and W., marked by an old tamarack stake, 3 ins. square, firmly set with 3 ft. of it above ground, marked with a scribo " $\frac{1}{4}$ S".

Set a concrete monument, 24 ins. long, 6 ins. diam., 18 ins. in the ground, for the $\frac{1}{4}$ sec. cor., with brass tablet, $3\frac{1}{2}$ ins. diam., 3 in. stem, embedded in top and mkd.,

S 21		S 22
------	--	------

1939

from which,

The remains of the original bearing trees,

A badly rotted and burned spruce stump, bears S. 86° E., 21 lks. dist.

A badly rotted and burned spruce stump, bears S. $62\frac{1}{2}^{\circ}$ W., 24 lks. dist.,

And new bearing trees,

A norway pine, 14 ins. diam., bears N. $2\frac{1}{4}^{\circ}$ E., 315 lks. dist., mkd. $\frac{1}{2}$ S 22 B T

A norway pine, 12 ins. diam., bears N. $9\frac{1}{2}^{\circ}$ W., 227 lks. dist., mkd. $\frac{1}{4}$ S 21 B T