


# U.S. PUBLIC LAND SURVEY MONUMENT RECORD

Note: This form is intended and designed to fulfill all requirements of Wisconsin Administrative Code, Chapter A-E 5.02, U.S. Public Land Survey Monument Record (3) (a) (b) (c) (d) (e) (f) (g) (h) (i). An additional sheet may be added if necessary to conform with said requirements.

(a) Corner location: Township 36 North  
 Range 8 East/West

Town/City/Village Crescent  
 County Oneida

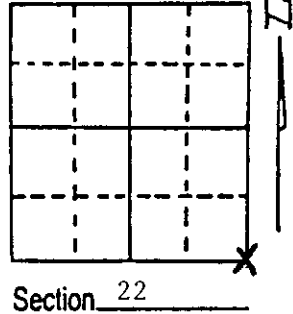


(b) (f) (g) (h) Description of monument found at this corner and if it was accepted, state all evidence (material, testimonial, occupational, plats, records, other monuments) used as a basis for accepting. If not accepted or if nothing was found, state evidence used as basis for establishing location. If reestablished through lost corner proportionate methods, indicate all monuments, distances and directions used to establish.

- 1863 - Wm. Daugherty established corner and set wood post:  
 20" White Pine, S24°E, 63 links      20" White Pine, N14°W, 40 links
- 1946 - Lytle and Hagen found both original pine stumps and made a new BT:  
 20" White Pine, N3°E, 55 links (36.60')
- 1974 - GLO found 2" x 18" iron pipe at corner position and pine stump N3°, 55 links
- 12/30/88 - I found 1 1/4" iron pipe with pine stump, N3°E, 36.6'. Pine stump has flat  
 axe face, scribing weathered away.  
 I accept this iron pipe as the perpetuated position of the original corner  
 and restore same.

(c) (d) (e) Plan view of corner with ties to at least 4 witness monuments. If in disagreement with previously established corner, show the distances between the two corners and also indicate the ties to the disputed corner.

- 1 - 2" x 36" Oneida County Aluminum Monument
- 2 - 10" Red Oak, N59°E, 16.58'
- 3 - 6" Red Maple, S45°E, 58.91'
- 4 - 10" Red Oak, S27°W, 29.29'
- 5 - 16" Red Oak, N28°W, 23.16'
- 6 - Plastic Sign Post, SW, 1.1'
- 7 - Remains of Lytles BT, N3°E, 36.6'

Note: BTs measured from nail in side of tree.  
 BTs scribed "T36N R8E Sxx BT"

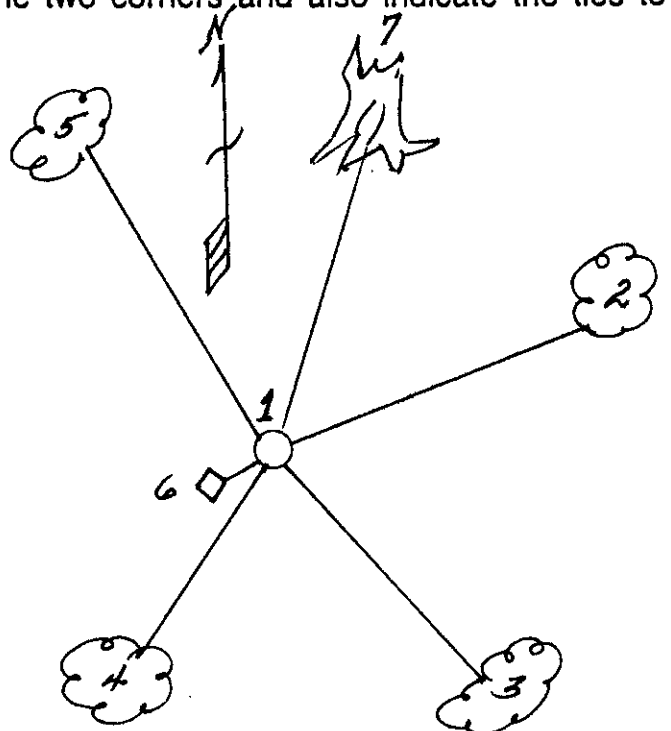

(i) I, Milo E. Stefan  
 (type or print name) certify that the corner location on this record was determined by me or under my direction and control and that this U.S. Public Land Survey Monument Record is correct and complete to the best of my knowledge and belief.

Milo E. Stefan      1/4/89  
 Signature      Date



Index No. R-17

3608220000