

U.S. PUBLIC LAND SURVEY MONUMENT RECORD


Note: This form is intended and designed to fulfill all requirements of Wisconsin Administrative Code, Chapter A-E 7.08 U.S. Public Land Survey Monument Record (3) (a) (b) (c) (d) (e) (f) (g) (h) (i). An additional sheet may be added if necessary to conform with said requirements.

(a) Corner location: Township 36 North

Range 8 East/West

Town/City/Village Crescent

County Oneida

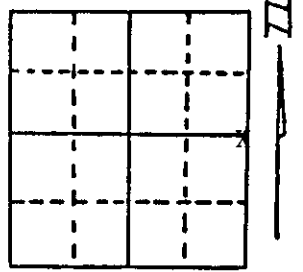

Section 22


(b) (f) (g) (h) Description of monument found at this corner and if it was accepted, state all evidence (material, testimonial, occupational, plats, records, other monuments) used as a basis for accepting. If not accepted or if nothing was found, state evidence used as basis for establishing location. If reestablished through lost corner proportionate methods, indicate all monuments, distances and directions used to establish. Indicate type of monument found or set and sign post.

- 1863 - Wm. Daugherty established corner and set wood post:
12" Birch, S69°W, 11 links 10" Birch, N57°E, 25 links
 - 1905 - Vaughan perpetuated corner from original evidence and made new BT:
White Pine, N22°W, 49 links (32.34')
 - 1946 - F. Hagen and Lytle found state and Vaughn's BT standing and all marks plain.
 - 1974 - GLO found 4" x 4" x 5' post with Vaughan BT rotted out. Now a pine snag,
N22°W, 49 links.
 - 12/30/88 - I found Vaughan's BT, 18" rotted White Pine, 20' snag. Corner position from snag is on north side of woods road with much recent logging activity. Post was not located. May be buried by logging debris; post hole, 30" deep. Very old traces of fence line westerly to pipeline.
- I accept this pine snag as the best remaining evidence of the perpetuated original corner position as well as the position accepted by GLO in the 1974 dependent resurvey of Section 22.

(c) (d) (e) Plan view of corner with ties to at least 4 witness monuments. If in disagreement with previously established corner, show the distances between the two corners and also indicate the ties to the disputed corner.

- 1 - 2" x 36" Oneida County Aluminum Monument
- 2 - 18" White Pine Snag, N22°W, 32.34'
- 3 - 8" Sugar Maple, N15°W, 38.71'
- 4 - 10" Sugar Maple, S85°W, 46.12'
- 5 - 8" Sugar Maple, S25°W, 40.67'
- 6 - 8" Red Oak, East, 65.92'
- 7 - Plastic Sign Post

Note: Distances to nail in side of BTs.
All BTs scribed "S1/4" "BT"

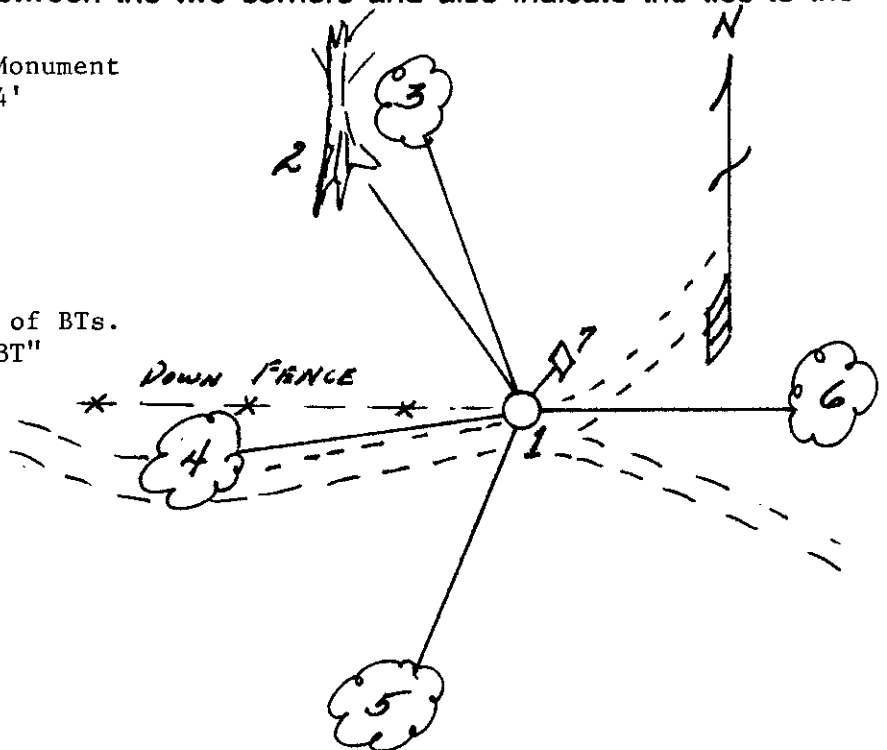

(i) I, Milo E. Stefan
(type or print name) certify that the corner location on this record was determined by me or under my direction and control and that this U.S. Public Land Survey Monument Record is correct and complete to the best of my knowledge and belief.

Milo E. Stefan
Signature

1/4/89
Date



Index No. P-17

3608 22 2000