

CERTIFIED LAND CORNER RESTORATION

State of Wisconsin }  
County of Oneida } ss.

I William Immich, do hereby certify that on the 12th day of Dec., 1981, I found evidence of the Southwest corner of Section 24 Township 36 North, Range 8 East, Fourth Principal Meridian, as described hereon; and that from this evidence I established a new monument and accessories as described hereon to perpetuate the original location of this corner:

Description of original monument and accessories and subsequent restorations:



- William Daugherty Government Surveyor 1863
- North between 25 & 26 80.00 set post corner to Sections 23, 24, 25 & 26 Elm 8 S 14 W 381k / sugar 12 S 7 E 59 1k
- 1905 D.H. Vaughn reset corner by proportionate measure
- 1957 Wisconsin Department of Transportation map shows corner just north of Dan Kress's garage.

Description of corner evidence found:

- 1980 W. Immich found railroad rail set in concrete just North of Dan Kress garage told by Dan Kress land owner that rail is corner and has been in place for over 40 years.

Description of monument and accessories I established to perpetuate the location of this corner:

Found railroad rail set in concrete 3 1/2 ' above ground, did not replace witnessed as shown

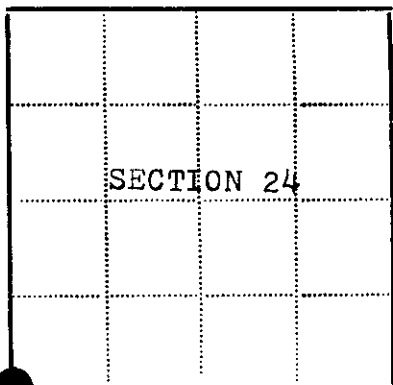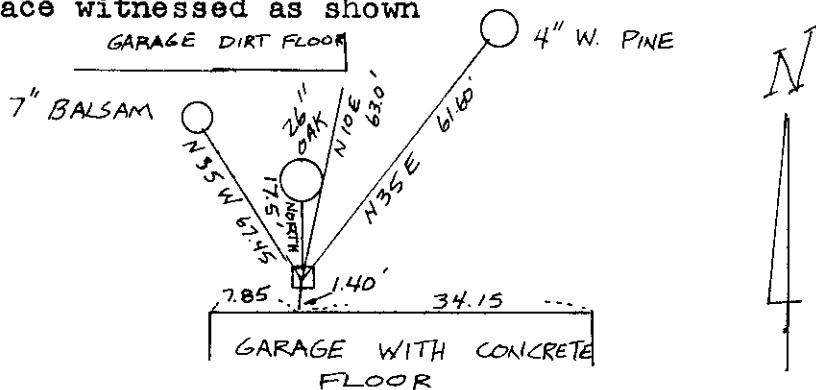

- - Corner monument restored
- -

Resident witnesses.....

Dated at Rhineland Wisconsin, this 12th day of Dec. 1981..

Signature William Immich Title R.L.S.  
(County Surveyor, Registered Land Surveyor, or other duly authorized official)

Surveyors Registration No. 1383

Office of REGISTER OF DEEDS County of Oneida

I hereby certify that the within instrument was filed in this office for record on the 17th day of September 1982 and was filed in Book No. .... Page No. .... of County Records.

Signature Louis Verage Kuehn Title REGISTER OF DEEDS

Township....., Range....., Section....., Index No....., Page No.....

36082-30000

R-21