


U.S. PUBLIC LAND SURVEY MONUMENT RECORD

Note: This form is intended and designed to fulfill all requirements of Wisconsin Administrative Code, Chapter A-E 5.02, U.S. Public Land Survey Monument Record (3) (a) (b) (c) (d) (e) (f) (g) (h) (i). An additional sheet may be added if necessary to conform with said requirements.

(a) Corner location: Township 36 North
 Range 8 East
 Town/City/Village Crescent
 County Oneida

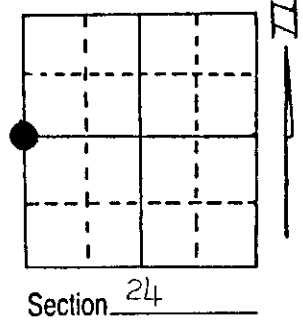

(b) (f) (g) (h) Description of monument found at this corner and if it was accepted, state all evidence (material, testimonial, occupational, plats, records, other monuments) used as a basis for accepting. If not accepted or if nothing was found, state evidence used as basis for establishing location. If reestablished through lost corner proportionate methods, indicate all monuments, distances and directions used to establish.

1863 William E. Daugherty North between Sec 23 & 24, 40.0 chains set post for $\frac{1}{4}$ cor. Spruce 8, N2 $\frac{1}{2}$ W, 515 lks. 57.6 chains creek 7 lks, runs west.

1905 D.H. Vaughn run line from $\frac{1}{4}$ cor. south to sec. cor.

1957 Highway Dept. show corner as being 15 ft.± west of center line.

1959 Norman Loftnus run east from $\frac{1}{4}$ cor. to establish center $\frac{1}{4}$ Center $\frac{1}{4}$, N80° 50' E, 39.135 chains (2582.91 ft)

Found: No evidence of $\frac{1}{4}$ cor. 1974 revised highway plan shows corner to be 15' west of center line and under 12' of fill.

Section corners monumented by William Immich in place.


Angle iron at South one sixteenth, no record.

Stream 3747 ft (56.8 ch.) north of south section cor.

I located $\frac{1}{4}$ cor. by using the south Sec. Cor. and the south 1/16 and projecting the line north twice the distance. This position falls 2639.54 ft. north of SW Sec. Cor. 2639.92 ft. south of NW Sec. Cor. and 13 ft. west of the center line highway. Straight line location would place cor. 45 ft. west of center line highway.


(c) (d) (e) Plan view of corner with ties to at least 4 witness monuments. If in disagreement with previously established corner, show the distances between the two corners and also indicate the ties to the disputed corner.

The quarter corner location being in the Highway, I set 2 Oneida County Monuments as witness corners on the East-West quarter line of Section 24. Monuments are stamped witness corner and the distance to corner shown. A 1 $\frac{1}{4}$ " diam. iron pipe 38" long was also on East-West Quarter line marking the west 10 Acres of the SW $\frac{1}{4}$, NW $\frac{1}{4}$ of Sec. 24. Bearing trees and references are given to the witness monuments.

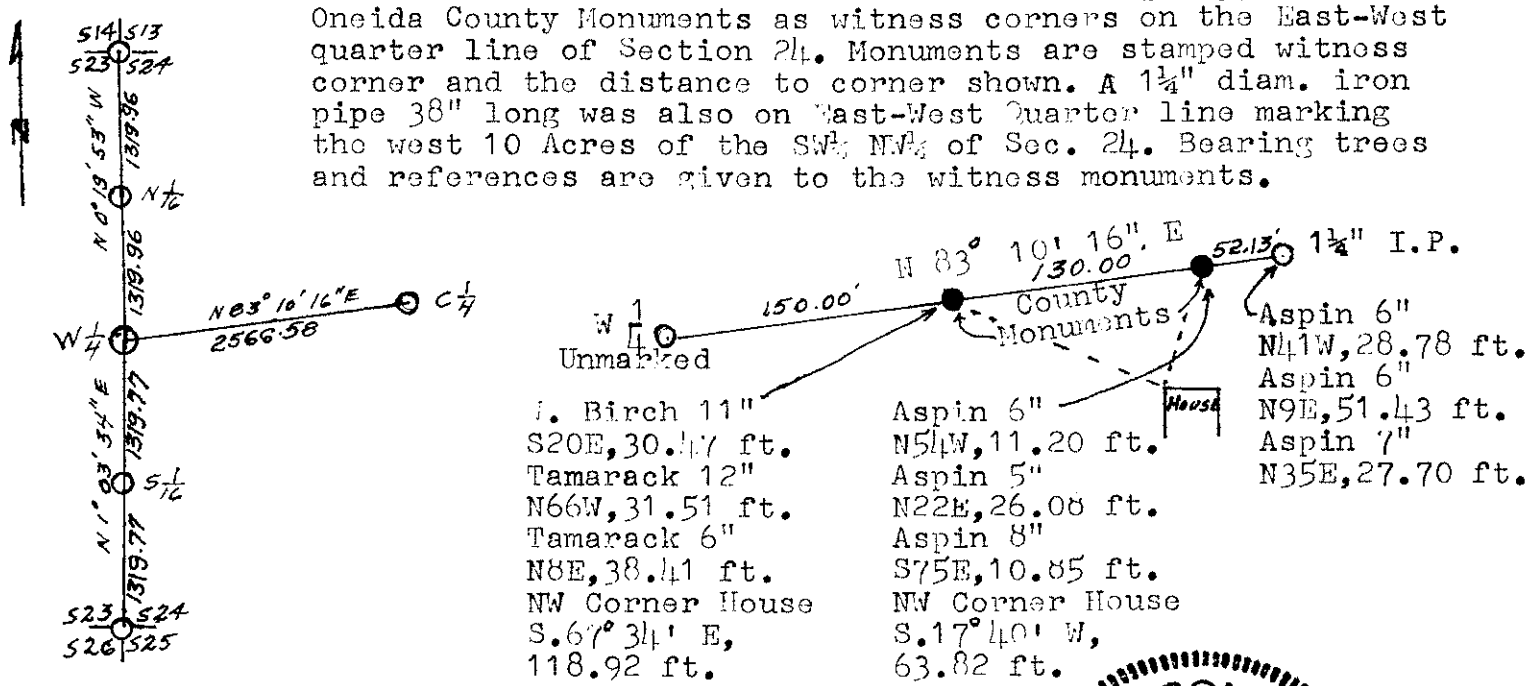

(i) I, Jean F. Resvick
 (type or print name) certify that the corner location on this record was determined by me or under my direction and control and that this U.S. Public Land Survey Monument Record is correct and complete to the best of my knowledge and belief.

Jean F. Resvick Date 6-4-88
 Signature Date

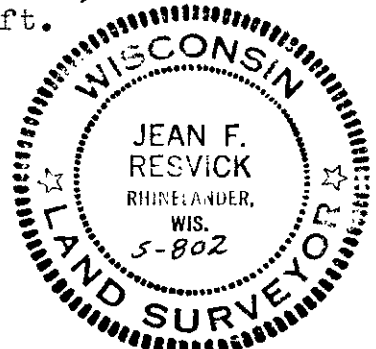

Index No. P-21

3608232000