

CERTIFIED LAND CORNER RESTORATION

Index No. V-3

State of Wisconsin }  
 County of Oneida } ss.

I Michael J. Romportl, do hereby certify that on the 22nd day of January, 1981, I found evidence of the North 1/4 corner of Section 31 Township 36, North, Range 8 East, Fourth Principal Meridian, as described hereon; and that from this evidence I established a new monument and accessories as described hereon to perpetuate the original location of this corner.

Resident witnesses:


History of original corner establishment:  
 Corner set by William Daugherty in 1863. East between Sections 30 & 31. 30.16 set 1/4 post.  
 BT Yellow Pine 10" N 71°E. 90 Links

Description of corner evidence found:  
 B.F. Dorr proportioned corner in 1898. No subsequent restorations on record.  
 Found 3/4" iron pipe end scribed cedar post. No BT's.

Description of monument and accessories I established to perpetuate the original location of this corner:  
 Iron pipe remains in place. Made 3 new BT's.

Balsam 12"	S 85°40' E	23.8'
Balsam 10"	S 5°40' W	51.3'
Oak 16"	S 66°50' W	79.0'

Distances are to center of trees.

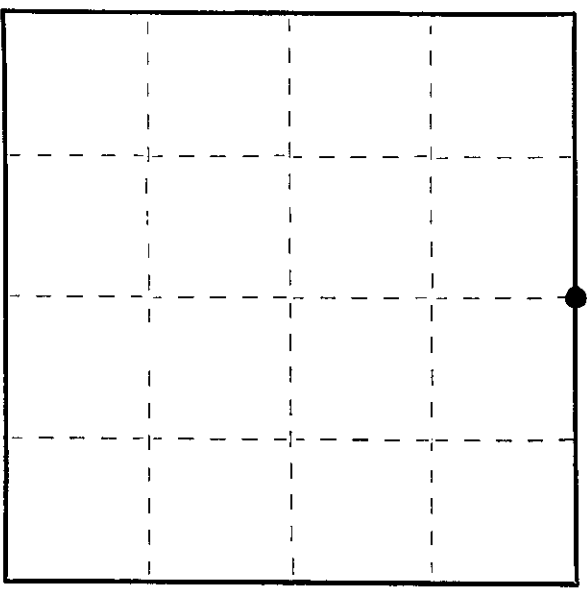


○ = Corner monument restored.

Dated at Rhineland, Wis., this 9th day of February, 1981.

Signature Michael J. Romportl Title Registered Land Surveyor Registration No. S 1624  
 (County Surveyor, Registered Land Surveyor, or other duly authorized official)

Office of Register of Deeds, County of Oneida  
 Instrument was filed in this office for record on the 11 day of June, 1981 at 8:02 o'clock P. M.

By Doris V. Savage (Register of Deeds)  
Deanna A. Pits Deputy

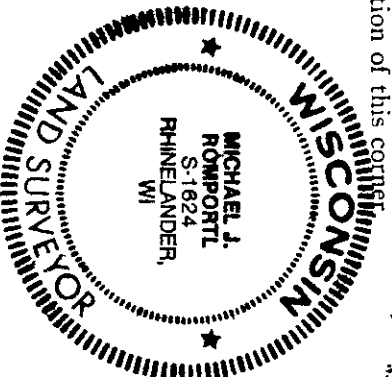

3608300020