U.S. PUBLIC LAND SURVEY MONUMENT RECORD

Note: This form is intended and designed to fulfill all requirements of Wisconsin Administrative Code, Chapter A-E 7.08 U.S. Public Land Survey Monument Record (3) (a) (b) (c) (d) (e) (f) (g) (h) (i). An additional sheet may be added if necessary to conform with said requirements.

(a) Corner location: Township 36 North

Range 8 East/West

Town/City/Village Crescent

County Oneida

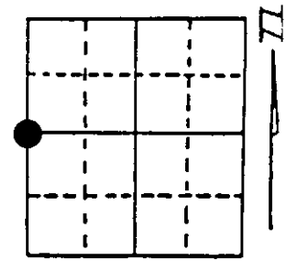

Section 29

(b) (f) (g) (h) Description of monument found at this corner and if it was accepted, state all evidence (material, testimonial, occupational, plats, records, other monuments) used as a basis for accepting. If not accepted or if nothing was found, state evidence used as basis for establishing location. If reestablished through lost corner proportionate methods, indicate all monuments, distances and directions used to establish. Indicate type of monument found or set and sign post.

1863 - Wm. Daugherty established this corner at 40.00 chains and set a wood post with two BTs:
10" Maple, N35°E, 22 Lks (14.52') 12" Aspen, N3°W, 80 Lks (52.80')

Late 1940's - County Surveyor, Wincentsen, restored this corner and made two BTs:
10" Oak, N62°E, 17.0' 8" Oak, N30°W, 8.7'

10/15/1992 - Milo E. Stefan found 2" x 30" iron pipe with both of Wincentsen's BTs in place. Iron pipe was out of position from BTs. I, therefore, placed a 2" x 30" aluminum monument flush with ground and made two new BTs and set sign post.

(c) (d) (e) Plan view of corner with ties to at least 4 witness monuments. If in disagreement with previously established corner, show the distances between the two corners and also indicate the ties to the disputed corner.

1) 2" x 30" aluminum monument.
2) 13" Red Oak, N70°E, 16.98'.
3) 12" Red Oak, S57°E, 21.85'.
4) 4" Sugar Maple, S70°W, 14.13'.
5) 11" Red Oak, N26°W, 8.70'.
6) Plastic sign post, West, .5'.

Distances to nail in side of BTs.
Stump blazes scribed "BT".

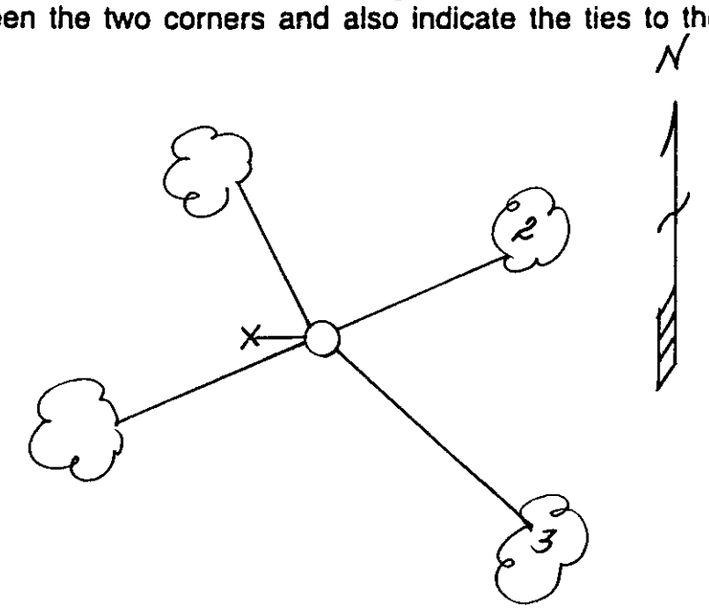

(i) I, Milo E. Stefan (type or print name) certify that the corner location on this record was determined by me or under my direction and control and that this U.S. Public Land Survey Monument Record is correct and complete to the best of my knowledge and belief.

Milo E. Stefan November 10, 1992

Signature Date

WISCONSIN MILO E. STEFAN S-1558 RHINELANDER, WIS. LAND SURVEYOR

Stamp 3608302000

Index No. T-5