


U.S. PUBLIC LAND SURVEY MONUMENT RECORD

Note: This form is intended and designed to fulfill all requirements of Wisconsin Administrative Code, Chapter A-E 7.08 U.S. Public Land Survey Monument Record (3) (a) (b) (c) (d) (e) (f) (g) (h) (i). An additional sheet may be added if necessary to conform with said requirements.

(a) Corner location: Township 36 North
 Range 8 East/West
 Town/City/Village Crescent
 County Oneida

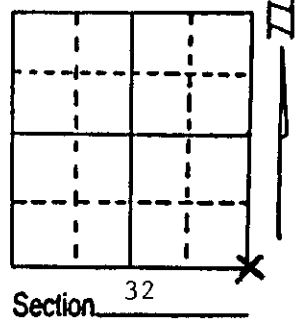

(b) (f) (g) (h) Description of monument found at this corner and if it was accepted, state all evidence (material, testimonial, occupational, plats, records, other monuments) used as a basis for accepting. If not accepted or if nothing was found, state evidence used as basis for establishing location. If reestablished through lost corner proportionate methods, indicate all monuments, distances and directions used to establish. Indicate type of monument found or set and sign post.

8/29/1860 - Alfred Millard established this corner at 80.00 chains and set a wood post with BTs as follows:

- | | |
|---------------------------|---------------------------|
| 7" Aspen, North, 25 links | 6" Cedar, S62°E, 15 links |
| 6" Aspen, S59°W, 21 links | 6" Aspen, N61°W, 16 links |

1937 - Francis X. Fuchs found old stake with turtle blaze on 5" Cedar, S52°W, 20 links.


He accepted this stake as the corner and set a 6" x 6" x 30" granite monument with BTs:
 12" White Pine, S56°W, 45½ links 6" Cedar, S42°E, 70.6 links

1/14/89 - Milo E. Stefan found Fuchs granite monument and White Pine BT (20"), S56°W, 30.2'.

(c) (d) (e) Plan view of corner with ties to at least 4 witness monuments. If in disagreement with previously established corner, show the distances between the two corners and also indicate the ties to the disputed corner.

1. 6" x 6" x 30" Pink Granite Monument in mound of stone
2. 7" Aspen, S85°E, 15.80'
3. 11" Cedar, S13°W, 24.10'
4. 20" White Pine, S56°W, 30.20'
5. 10" Cedar, S89°W, 56.00'
6. Plastic sign post, NE, 1.0'

BTs scribed "BT" at stump blaze
 Distances to nail in side of trees

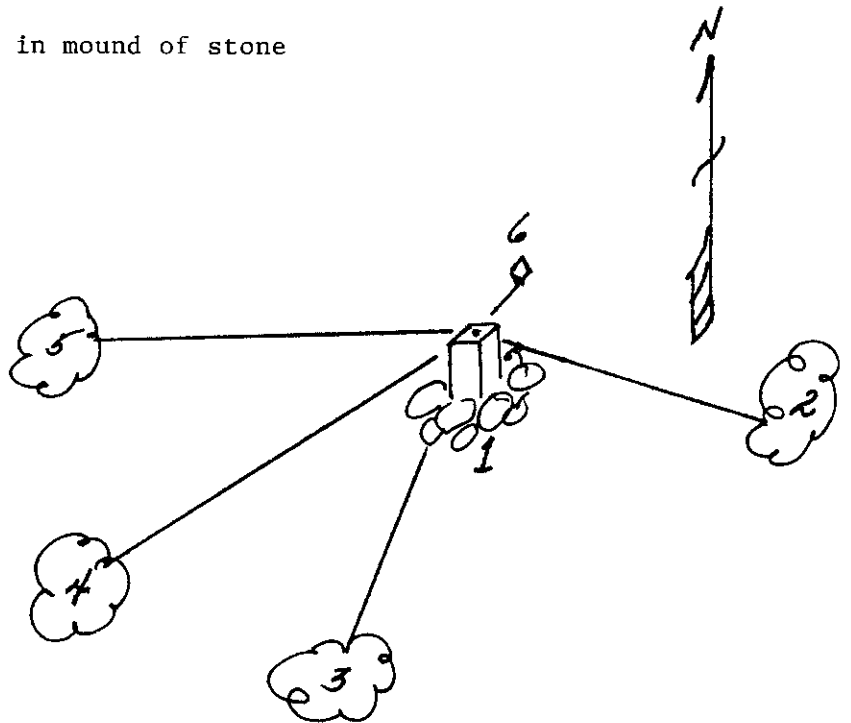

(i) I, Milo E. Stefan
 (type or print name) certify that the corner location on this record was determined by me or under my direction and control and that this U.S. Public Land Survey Monument Record is correct and complete to the best of my knowledge and belief.

Milo E. Stefan 2/16/89
 Signature Date



Index No. Z-9

3608.32.0000

