U.S. PUBLIC LAND SURVEY MONUMENT RECORD

Note: This form is intended and designed to fulfill all requirements of Wisconsin Administrative Code, Chapter A-E 7.08 U.S. Public Land Survey Monument Record (3)(a)(b)(c)(d)(e)(f)(g)(h)(i). An additional sheet may be added if necessary to conform with said requirements.

(a) Corner location: Township 36 North

Range 08 East/West

Town/City/Village CRESCENT

County ONEIDA

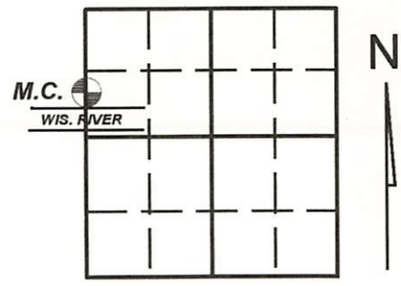

Section 35

(b) (f) (g) (h) Description of monument found at this corner and if it was accepted, state all evidence (material, testimonial, occupational, plats, records, other monuments)used as a basis for accepting. If not accepted or if nothing was found, state evidence used as basis for establishing location. If reestablished through lost corner proportionate methods, indicate all monuments, distances and directions used to establish. Indicate type of monument found or set and sign post.

-JULY 1863- U.S. Government surveyor set meander post at 49.98 chains north of the southwest corner of section 35 on the left bank of the Wisconsin River and made the following witness trees: ASPEN 6", N39°E, 68 LINKS, ASPEN 8" N41°W, 62 LINKS

-JUNE 2010- Kevin Bixby set 2" x 24" iron pipe on left bank of Wisconsin River and witnessed as shown below.

REGISTER OF DEEDS OFFICE
ONEIDA COUNTY
FILED

APR 29 2022

KYLE J. FRANSON
REGISTER OF DEEDS

(c) (d) (e) Plan view of corner with ties to at least 4 witness monuments. If in disagreement with previously established corner, show the distances between the two corners and also indicate the ties to the disputed corner.

N

Angles and distances measured with total station.

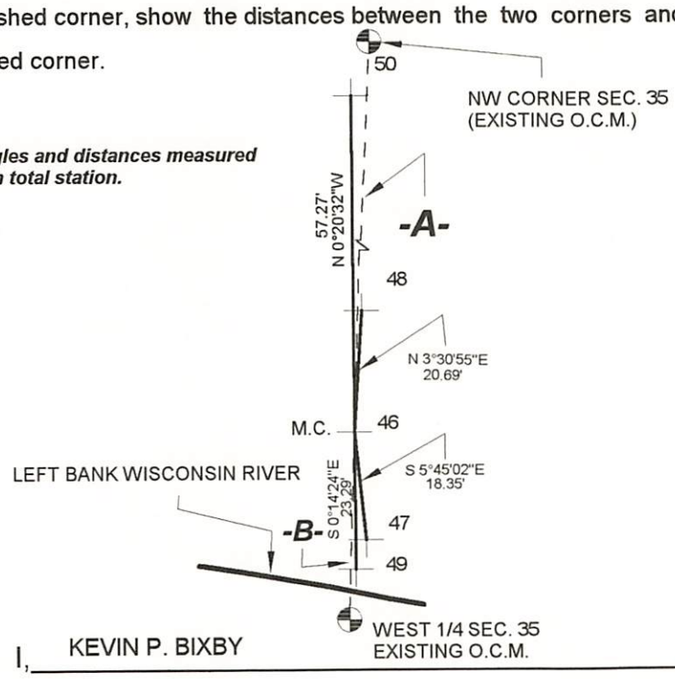

SCALE: 1"=30'

LINE TABLE

LINE LETTER	BEARING	DISTANCE
B	N00°02'35"E	715.69'
A	N00°02'35"E	1895.33'

LEGEND

-46- SET 2" X 24" IRON PIPE

-47- EXISTING 3/4" IRON PIPE

-48- EXISTING 1" IRON PIPE

-49- SET SPIKE IN 30" TWIN MAPLE

-50- SET SPIKE IN 10" MAPLE

(i) I, KEVIN P. BIXBY (type or print name) certify that the corner location on this record was determined by me or under my direction and control and that this U.S. Public Land Survey Monument Record is correct and complete to the best of my knowledge and belief.

Kevin P. Bixby
Signature

07/08/10
Date

WISCONSIN
KEVIN P.
BIXBY
S-2343
GLEASON,
WI
LAND SURVEYOR

Stamp

3608342600

Index No. WX-17