

CERTIFIED LAND CORNER RESTORATION
U.S. Public Land Survey Monument Record

State of Wisconsin
County of Oneida } ss.

I, James F. Kasson, do hereby certify that on the 27 day of August, 1982, I found evidence of the Northeast Section corner of Section 9 Township 36 North Range 9 East, Fourth Principal Meridian, as described hereon; and that from this evidence I established a new monument and accessories as described hereon to perpetuate the original location of this corner:

Description of original monument and accessories and subsequent restorations:

wood post BT. 5 1/2" W. pine S39W 191Ks
BIRCH 8" J 64E 171Ks


This corner by evidence of deeds was the perpetuation of an original corner and was last perpetuated by Surveyor Kieth Hall. Hall set a 2" iron pipe and the following witnesses: Yellow Pine S50E, 76.7'
X in Black Boulder S8E, 46.25'
X in Black Boulder S84 15'E 40.7'

Description of corner evidence found:


I found 2" iron pipe approximately 66' East of the shore of Bullhead Lake, corner falls in low area but is quite secure. I also found the following Witnesses: X in Black Boulder S8E, 46.60 (.35 longer than Hall's measurement)
X in Black Boulder S84E, 40.6' (.1' short of Hall)
14" W. Pine N80W, 11.5'
12" W. Pine S84E 11.45'

Description of monument and accessories I established to perpetuate the location of this corner:

I left 2" iron pipe and all accessories mentioned above and set the following: 1"x30" iron pipe N88 32'00"W, 46.56'
1"x30" iron pipe S3 54'00"W, 150.83' on northerly row line of Town Road.

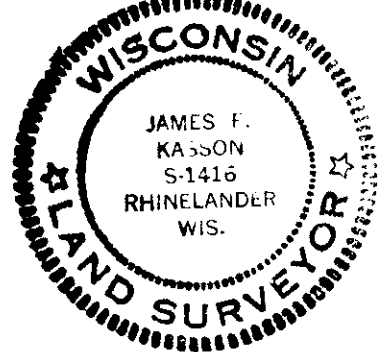

Sec. 9 T36N, R9E

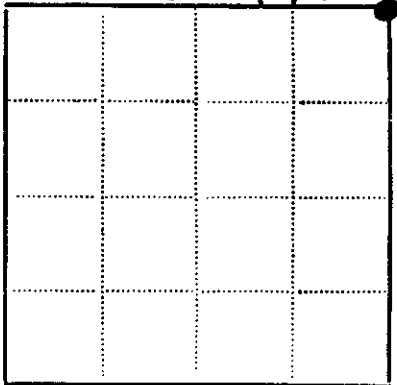

● - Corner monument restored
□ -

Resident witnesses

Dated at Rhinelander, WI Wisconsin, this 5 day of Oct. 1982

Signature James F. Kasson Title
(County Surveyor, Registered Land Surveyor, or other duly authorized official)

Surveyors Registration No. 1416

Office of Reg. of Deeds County of Oneida

I hereby certify that the within instrument was filed in this office for record on the 11 day of June 1986, and was filed in Book No. Page No. of County Records.

Signature Dennis Veray Title Reg. of Deeds
Cynthia A. Pites Deputy

Township, Range, Section, Index No., Page No.