

CERTIFIED LAND CORNER RESTORATION FOR U.S. PUBLIC LAND SURVEY MONUMENT RECORD

State of Wisconsin } ss. County of Oneida

I William E. Badow do hereby certify that on the 6th day of December, 1982, I found evidence of the South 1/4 corner of Section 5 Township 36 North Range 9 East, Fourth Principal Meridian, as described hereon; and that from this evidence I established a new monument and accessories as described hereon to perpetuate the original location of this corner:

Description of original monument and accessories and subsequent restorations: Corner by William Daugherty in 1863. West between Sections 5 & 8 40.10 set 1/4 post. BT's Birch 7" N13E 12, W. Pine 12" S72W 17. both Dorr & Vaughan found & used corner but made no ET's. Hall was at corner April, 1933 & said he found an iron pipe. Abernathy found an iron pipe in January, 1952 & used it for the 1st Addition to Forest Home Cemetery.


Description of corner evidence found: Found 1 1/2" iron pipe in cemetery. Pipe appears to match position Shown on 1st Addition to Forest Home Cemetery.

Description of monument and accessories I established to perpetuate the location of this corner: Iron pipe remains in place. Made new ET's: 5" spike 1' above ground in 16" N. Pine S20E 9.82' 5" spike 3.5' above ground in 24" W. Pine N75W 71.15'



See back for diagram Compared with the record & Accepted as correct. Robert H. Kinat ONEIDA COUNTY SURVEYOR

SECTION 5, T36N, R9E

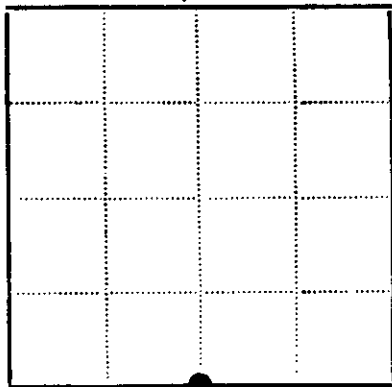

Legend: Circle - Corner monument restored, Square -

Resident witnesses.....

Dated at Rhinelander Wisconsin, this 9th day of December 1982.

Signature William E Badow Title Registered Surveyor (County Surveyor, Registered Land Surveyor, or other duly authorized official)

Surveyors Registration No. S-1182

Office of Register of Deeds County of Oneida

I hereby certify that the within instrument was filed in this office for record on the 15th day of December 1982, and was filed in Book No. Page No. of County Records.

Signature Doris Verage Kuehn Title Register of Deeds

Township 36 North Range 9 East Section 5 Index No. E-7 Page No.

N



24" W. PINE

N 75° W  
71.15'

S 20° E 9.82'

16" N. PINE

