


U.S. PUBLIC LAND SURVEY MONUMENT RECORD

Note: This form is intended and designed to fulfill all requirements of Wisconsin Administrative Code, Chapter A-E 7.08 U.S. Public Land Survey Monument Record (3) (a) (b) (c) (d) (e) (f) (g) (h) (i). An additional sheet may be added if necessary to conform with said requirements.

(a) Corner location: Township 36 North
 Range 9 East/West


Town/City/Village Pelican
 County Oneida

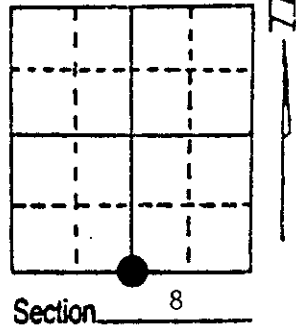

(b) (f) (g) (h) Description of monument found at this corner and if it was accepted, state all evidence (material, testimonial, occupational, plats, records, other monuments) used as a basis for accepting. If not accepted or if nothing was found, state evidence used as basis for establishing location. If reestablished through lost corner proportionate methods, indicate all monuments, distances and directions used to establish. Indicate type of monument found or set and sign post.

- 1863 - Corner was originally set by Wm. E. Dougherty. He tied the following bearing trees: 12" Hemlock, N9°E, 39 lks; 8" Sugar, S16°W, 16 lks.
- 1892 - A survey was made by B. F. Dorr of the SW $\frac{1}{4}$ of Sec. 8 and he measured the distance from the SW corner of Sec. 8 to the S $\frac{1}{4}$ corner to be 3045.24'.
- 1892 - A survey of the SW $\frac{1}{4}$ of the SW $\frac{1}{4}$ was completed by B. F. Dorr and he subdivided Shaw and Dorr's Outlots. In this plat, he shows the S. line of the SW $\frac{1}{4}$ of the SW $\frac{1}{4}$ to be 1522.62'.
- 1973 - No monument could be found at this corner, however, the south line of Shaw and Dorr's Outlots could be found. I set the S $\frac{1}{4}$ corner on an extension of the south line and 1522.62'E of the 1/8 corner. I set a DOT monument.
- 1973 - Wis. Dept. of Trans. found and accepted DOT mon.
- 1989 - I found and accepted Wis. Dept. of Trans. mon. 1' west of pavement.

(c) (d) (e) Plan view of corner with ties to at least 4 witness monuments. If in disagreement with previously established corner, show the distances between the two corners and also indicate the ties to the disputed corner.

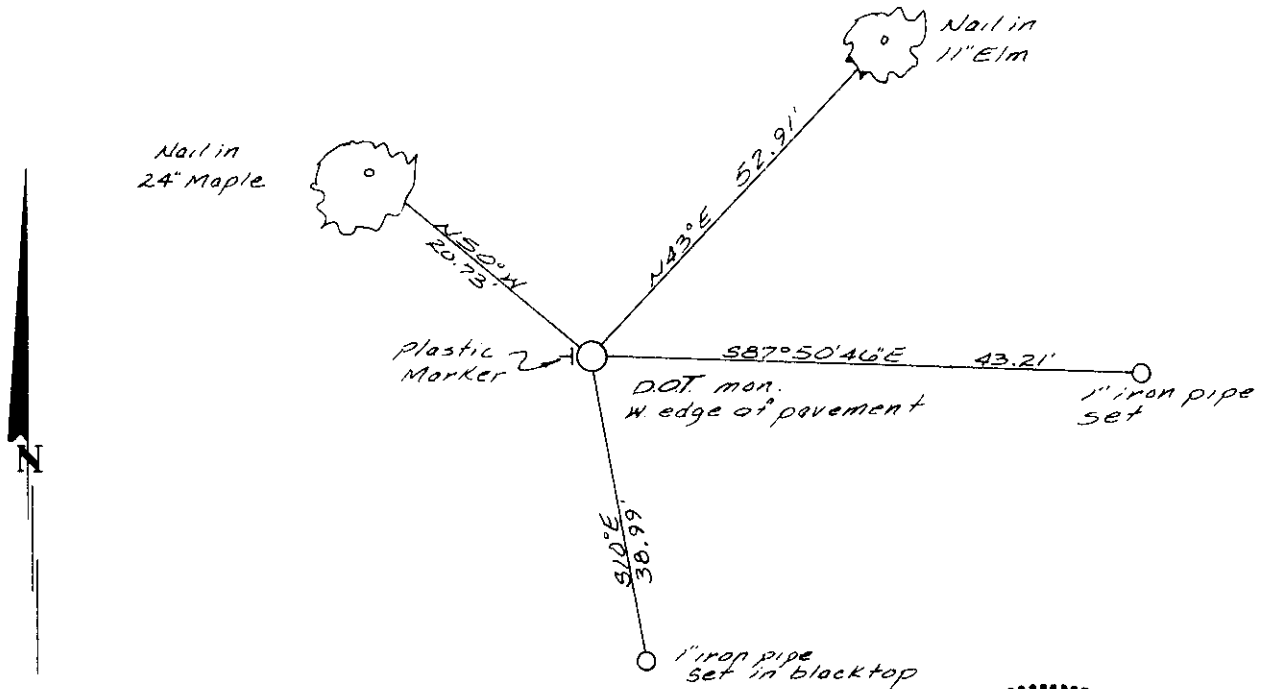

(i) I, Gerald B. Inman
 (type or print name) certify that the corner location on this record was determined by me or under my direction and control and that this U.S. Public Land Survey Monument Record is correct and complete to the best of my knowledge and belief.

Gerald B. Inman
 Signature

October 27, 1989
 Date



Index No. J-7

360908020