

This form is intended to fulfill the requirements of Chapter A-E 7.08 (3)(a) thru (i) U.S. Public Land Survey Monument Location Record, Wisconsin Administrative Code. Use the reverse side of form for continuation.

U.S. PUBLIC LAND SURVEY MONUMENT LOCATION RECORD

Recorders Data

USPLS CORNER: SOUTH WITNESS MC SECTION: 11 TOWNSHIP: 36 NORTH RANGE: 09 EAST

NAME OF WATERWAY FOR M.C. CORNER : MIDGET LAKE SECTION LINE: WEST

(CITY)(VILLAGE)(TOWN) OF: PELICAN COUNTY OF: ONEIDA

Description of monument found or placed and all other evidence used as the basis for monument location; including monuments and related measurements required if the corner location was reestablished by lost corner proportionate methods. Also indicate name of original surveyor, original survey date and the corner monument, bearing trees, witness or other reference monuments established; including measured bearing and distance ties, from available records.

Found and accepted an undisturbed and plumb 1.25"x1.25" steel 'T' iron 18" high at this corner location with blue, orange and yellow flagging tape attached. I left the iron in place and drove a standard 2" dia. by 30" long aluminum pipe monument with stamped Oneida County cap over it to 4" above grade. During my walk-in from the South, I found remnants of an old fenceline leading North to the corner. No old BTs or other evidence was observed this date.


In August 1865, William E. Daugherty/GLO set a wood post as the original corner and marked OBTs: An 8" Tamarack N70°W 18 links and a 6" Tamarack S31°E 20 links; in 1924, D.S. Burnette set an MC post on South shore of Midget Lake and noted same OBT's, which may be probable with Tamarack due to very slow growth and durability, even after becoming standing dead pikes during the 59 years since they were marked by Daugherty; all are now obliterated.

In 1958, Genisot Engineering Co. of Rhinelander, Wis. note this corner as having been set by previous survey per Plat of Survey B-1277 in Oneida County survey records; they may have replaced Burnettes post with an iron pipe per my query.

In 1975, Genisot & Associates, Inc. of Rhinelander, Wis. note an iron pipe at this corner per Plat of Survey B-2920 in Oneida County survey records; I could not find the iron pipe at this corner location or in nearby area with locator.

In 1984, Robert H. Winat/RLS 1040, indicates this corner with a 'T' symbol on Plat of Survey C-1770 in Oneida County survey records; I queried him by phone call on September 19, 2001 and confirmed that he had found and used the 'T' iron existing at this corner and also had not found any iron pipe nor BTs at such location.

Plan view map of monument location with bearing and distance ties to a minimum of four(4) described witness or reference monuments of concrete, natural stone, iron, live bearing trees or equivalent material. If applicable, also show a minimum of two(2) bearing and distance ties to any other monument found and not accepted; including the bearing and distance from the accepted monument.

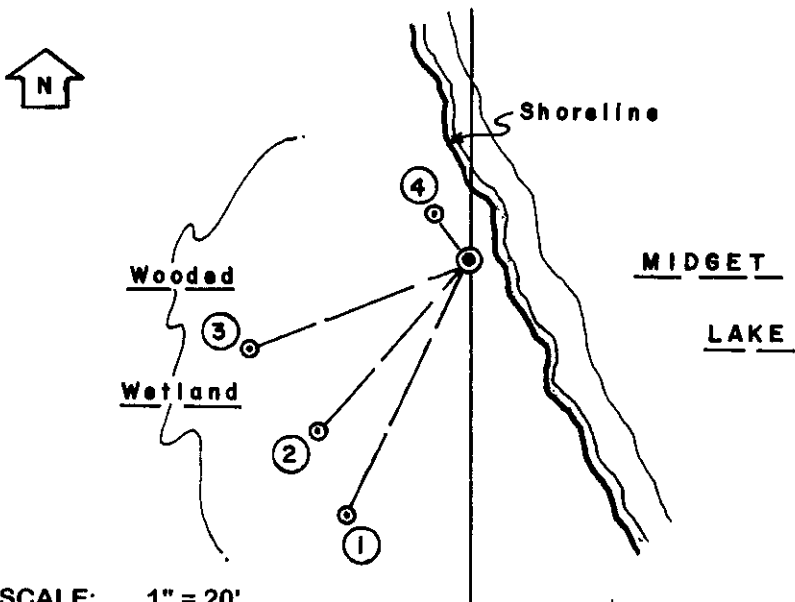

WITNESS MONUMENT TIES:

- ① New BT 9" Mr S26°W 30.32'.
- ② New BT 6" Pw S42°W 24.58'.
- ③ New BT 9" Mr S67°W 23.70'.
- ④ New BT 8" Mr N41°W 5.92'.

Standard white poly 'T' corner marker post set 6" West of corner monument.

Corner falls about 3.5' West of existing shoreline of Midget Lake this date.

An old rusted steel barrel found 3' SW of the corner.

This recovery completed September 13, 2001; there were no witnesses.

SCALE: 1" = 20'

Unless otherwise indicated, all bearing tree ties are to a .25" dia. by 2.5" long PK nail with a 1.25" dia. steel washer driven into unblazed right face and a .25" dia. by 2.5" long PK nail with a 2" dia. steel washer stamped BT is also driven into unblazed face of bearing tree at DBH; the basis for measured bearings is by compass to nearest degree and all tie distances are measured horizontal by steel tape corrected to nearest 1/100th feet at standard temperature of 68° F.

RLS SEAL:



LAND SURVEYOR CERTIFICATE:

I, William C. Rohde, hereby certify that I am duly licensed as a Professional Land Surveyor in the State of Wisconsin; that this USPLS monument location was determined by me and/or under my direct supervision and control; and that this U.S. Public Land Survey Monument Location Record is true and correct to the best of my knowledge and belief.

Signed *William C. Rohde*
William C. Rohde RLS 841

