


U.S. PUBLIC LAND SURVEY MONUMENT RECORD

Note: This form is intended and designed to fulfill all requirements of Wisconsin Administrative Code, Chapter A-E 7.08 U.S. Public Land Survey Monument Record (3) (a) (b) (c) (d) (e) (f) (g) (h) (i). An additional sheet may be added if necessary to conform with said requirements.

(a) Corner location: Township 36 North
 Range 9 East/West

Town/City/Village Pelican
 County Oneida

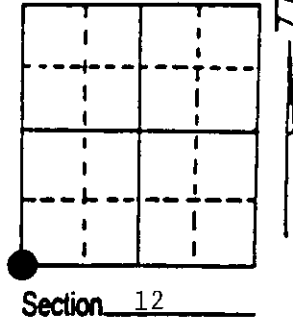


(b) (f) (g) (h) Description of monument found at this corner and if it was accepted, state all evidence (material, testimonial, occupational, plats, records, other monuments) used as a basis for accepting. If not accepted or if nothing was found, state evidence used as basis for establishing location. If reestablished through lost corner proportionate methods, indicate all monuments, distances and directions used to establish. Indicate type of monument found or set and sign post.

- 1863 - Wm. Daugherty established corner, set post and BTs:
 10" Birch, S28°E, 415 Links 6" Birch, N46½°E, 122 Links
- 19 ? - Vaughn restored corner by Unconventional Methods. Made BTs:
 36" White Pine Stump, N65½°W, 33 Links (21.78')
 16" White Pine Stump, S11°E, 16 Links (10.56')
- 4/23/1924 - Burnett checked Vaughn work and agreed with him that the Section Corner was restored to a reasonable position. He used it to tie plat of "Alburleigh Shores".
- 6/4/1993 - Milo E. Stefan found a 1 1/4" iron pipe inside a drive shaft with remains of Vaughn's BTs. Also, a scribed Red Pine Stump, S10°W, 9.78'. We replaced drive shaft and iron pipe with a 2" x 30" aluminum monument, made new BTs and set plastic sign post.

(c) (d) (e) Plan view of corner with ties to at least 4 witness monuments. If in disagreement with previously established corner, show the distances between the two corners and also indicate the ties to the disputed corner.

- 1) 2" x 30" aluminum county monument.
- *2) 8" Red Oak, North, 43.73'.
- *3) 14" Red Pine, N22°E, 54.31'.
- 4) 4" White Pine, N73°E, 34.76' (X only).
- *5) 12" Red Maple, S54°W, 23.92'.
- 6) Red Pine Stump, S10°W, 9.78'.
- 7) Large White Pine Stump, N65°W, 22.0'.
- 8) Stump hole, S11°E, 10.56'.
- 9) Plastic sign post, North, 1.0'.

Distances to nail in side of BTs.
 *Stump blaze scribed "BT".

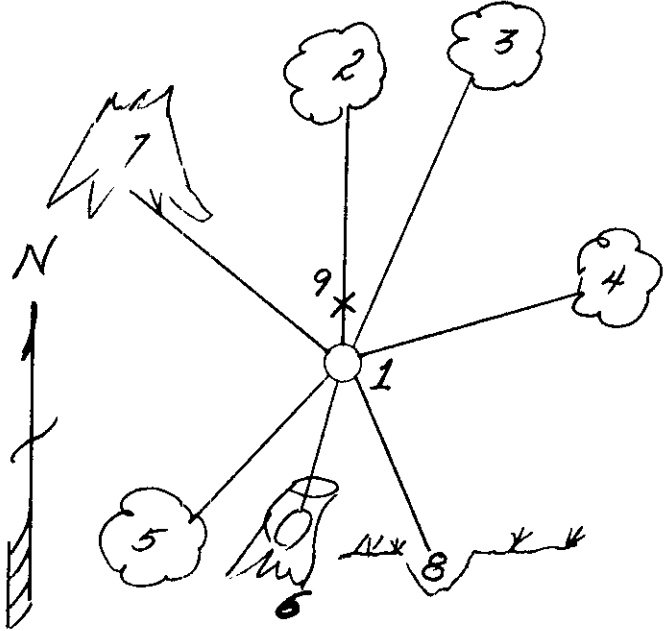

(i) I, Milo E. Stefan
 (type or print name) certify that the corner location on this record was determined by me or under my direction and control and that this U.S. Public Land Survey Monument Record is correct and complete to the best of my knowledge and belief.

Milo E. Stefan June 27, 1993
 Signature Date



Index No. J-21