

This form is intended to fulfill the requirements of Chapter A-E 7.08 (3)(a) thru (i) U.S. Public Land Survey Monument Location Record, Wisconsin Administrative Code. Use the reverse side of form for continuation.

U.S. PUBLIC LAND SURVEY MONUMENT LOCATION RECORD

Recorders Data

USPLS CORNER: WEST WITNESS MC SECTION: 14 TOWNSHIP: 36 NORTH RANGE: 09 EAST

NAME OF WATERWAY FOR M.C. CORNER : GEORGE LAKE SECTION LINE: NORTH

(CITY)(VILLAGE)(TOWN) OF: PELICAN COUNTY OF: ONEIDA

Description of monument found or placed and all other evidence used as the basis for monument location; including monuments and related measurements required if the corner location was reestablished by lost corner proportionate methods. Also indicate name of original surveyor, original survey date and the corner monument, bearing trees, witness or other reference monuments established; including measured bearing and distance ties, from available records.

Found and accepted an older 1.25" dia. galvanized iron pipe with uncapped top at existing lake shoreline this date. I reset the iron pipe deeper and plumb for new ties and drove a standard 2" dia. by 30" long aluminum pipe monument with split bottom end and stamped Oneida County cap over the iron pipe flush with top edge of lake bank and further protected the monument from lake wash erosion with concrete blocks and coarse stone backfill at waters edge. No old BTs observed.

In August 1865, William E. Daugherty/GLO set a wood post as the original meander corner and marked OBTs: An 8" Aspen S60°W 111 links and a 6" Aspen N11°W 35 links; all of which are now obliterated.


In April 1924, D.S. Burnett set this MC with a wood post on section line extension from East MC across George Lake and noted the same dia. OBT species, bearing and distance ties as indicated in original 1865 GLO survey notes?? per Old Field Book Page 20 in Oneida County records; and later in June 1924 Burnette notes this corner per Plat of Alburmi Shores in Oneida County records.

In 1932, C.W. Fisher notes this corner per Replat of Block 2 of Alburmi Shores Plat in Oneida County survey records.

In 1959, R.M. Rowinski/RLS notes this corner and a 9" Or BT N70°W 15.4', now gone, per Plats of Survey A-944 and B-1828 in Oneida County survey records.

In 1992, James L. Will/RLS 1410 notes a 1.5" dia. pipe at this corner per Plat of Survey B-2709 Oneida Co. survey records.

Plan view map of monument location with bearing and distance ties to a minimum of four(4) described witness or reference monuments of concrete, natural stone, iron, live bearing trees or equivalent material. If applicable, also show a minimum of two(2) bearing and distance ties to any other monument found and not accepted; including the bearing and distance from the accepted monument.

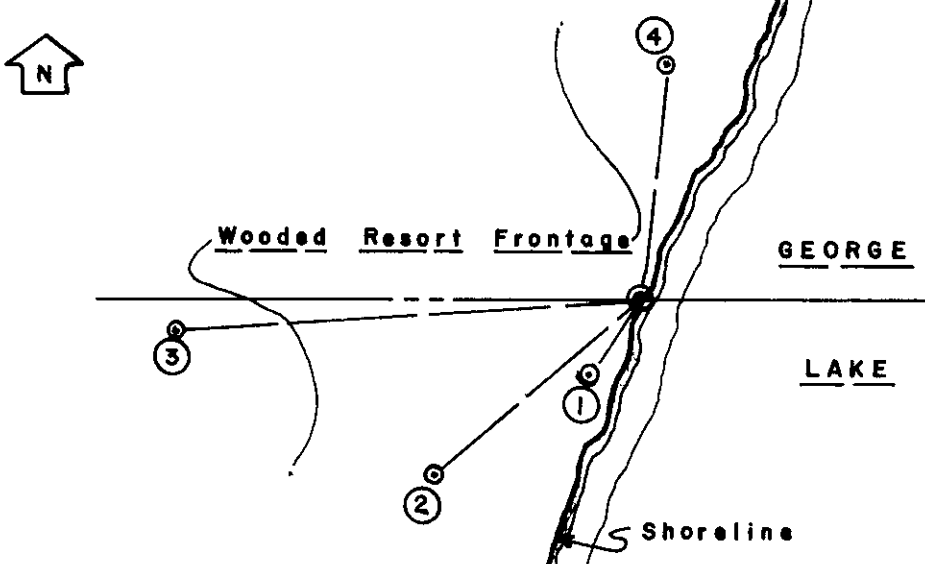

WITNESS MONUMENT TIES:

- ① New BT 18" Sb S35°W 19.50'.
- ② New BT 24" Or S41°W 56.60'.
- ③ New BT 16" Pw S86°W 96.85'.
- ④ New BT 27" Or N06°E 48.80'.

Standard white poly 'T' corner marker post set 4" North of corner monument in improved lake frontage lawn area.

This recovery completed September 13, 2001 and witnessed by adjoining resort owner Jay Miller.

Corner is directly South of cabin named "Wrightwood" on lake shore.

SCALE: 1" = 40'

Unless otherwise indicated, all bearing tree ties are to a .25" dia. by 2.5" long PK nail with a 1.25" dia. steel washer driven into unblazed right face and a .25" dia. by 2.5" long PK nail with a 2" dia. steel washer stamped BT is also driven into unblazed face of bearing tree at DBH; the basis for measured bearings is by compass to nearest degree and all tie distances are measured horizontal by steel tape corrected to nearest 1/100th feet at standard temperature of 68° F.

RLS SEAL:




LAND SURVEYOR CERTIFICATE:

I, William C. Rohde, hereby certify that I am duly licensed as a Professional Land Surveyor in the State of Wisconsin; that this USPLS monument location was determined by me and/or under my direct supervision and control; and that this U.S. Public Land Survey Monument Location Record is true and correct to the best of my knowledge and belief.

Signed *William C. Rohde*
William C. Rohde RLS 841

Date Signed: March 25, 2002

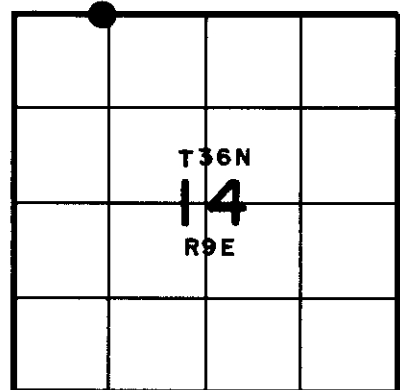

SECTION LOCATION MAP

INDEX NO. *14*