

CERTIFIED LAND CORNER RESTORATION

State of Wisconsin }
County of Oneida } ss.

I James F. Kasson do hereby certify that on the 24 day of January, 19 81, I found evidence of the South 1/4 corner of 14 Township 36 North Range (9 East, Fourth Principal Meridian, as described hereon; and that from this evidence I established a new monument and accessories as described hereon to perpetuate the original location of this corner:

Description of original monument and accessories and subsequent restorations:

1/2" brass plug set by Kieth hall as recorded in Vol. 195m, onpage 602, this was a perpetuation of corner set by D.H. Vaughn in 1909
12/6/75 Dept. of Transportation found brass plug and stated they drove railroad spike over it.

Description of corner evidence found:

I found P.K. nail in highway with 4 other P.K. nails surrounding it. P.K. nail in center coincided with the following witnesses set by the Dept. of Transportation.

Magnetic Cast aluminum monuments at:


N45°E 79.68' S1°E, 81.2' (this is Vaughn's BT)

S49°E 77.62'

S45°W 69.00'

N49°W 65.19' (this is measurement stamped on mon. not that on cert. form)

Description of monument and accessories I established to perpetuate the location of this corner:

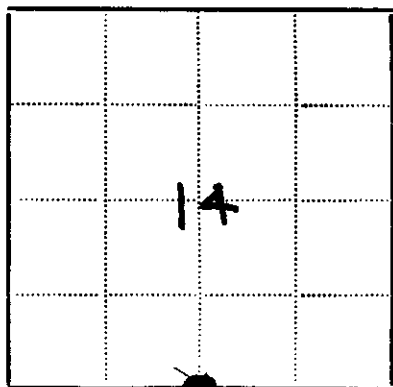

● - Corner monument restored

□ -

Resident witnesses.....

Dated at Rhinelander Wisconsin, this 10 day of Feb. 19 81.

Signature *James F. Kasson* Title *R.L.S.*
(County Surveyor, Registered Land Surveyor, or other duly authorized official)

Surveyors Registration No.....

Office of *Register of Deeds* County of *Oneida*

I hereby certify that the within instrument was filed in this office for record on the 11 day of *June* 1986, and was filed in Book No. Page No. of County Records.

Signature *James Verag* Title *Reg of Deeds*
Cynthia A. Pitts Deputy

Township....., Range....., Section....., Index No....., Page No.....

3609140020

N-19