

This form is intended to fulfill the requirements of Chapter A-E 7.08 (3)(a) thru (i) U.S. Public Land Survey Monument Location Record, Wisconsin Administrative Code. Use the reverse side of form for continuation.

U.S. PUBLIC LAND SURVEY MONUMENT LOCATION RECORD

Recorders Data

USPLS CORNER: SOUTH WITNESS MC SECTION: 13 TOWNSHIP: 36 NORTH RANGE: 09 EAST

NAME OF WATERWAY FOR M.C. CORNER : GEORGE LAKE SECTION LINE: WEST

(CITY)(VILLAGE)(TOWN) OF: PELICAN COUNTY OF: ONEIDA


Description of monument found or placed and all other evidence used as the basis for monument location; including monuments and related measurements required if the corner location was reestablished by lost corner proportionate methods. Also indicate name of original surveyor, original survey date and the corner monument, bearing trees, witness or other reference monuments established; including measured bearing and distance ties, from available records.

Found and accepted an uncapped 3/4" dia. iron pipe with upper 9" bent, so I carefully excavated to reveal the vertical soil cavity of the bottom 16" of the pipe and reset it with a standard 2" dia. by 30" long aluminum pipe monument with split bottom end and stamped Oneida County cap nearly flush to existing grade. Old bent iron pipe left flat on grade nearby.

In August 1865, William E. Daugherty/GLO set a wood post as the original corner and marked OBTs: A ?dia. Bw S07°E 118 links and a 16" Tamarack S13°W 106 links; all now obliterated; in August 1912, D.H. Vaughan found GLO MC post gone and set a new witness MC post and marked new BTs: a 17" Pw stump South 55 links, as nothing else near, per notes on Page 67 of Old Fieldbook 7 in Oneida County survey records; post and BT now obliterated. In April 1924, D.S. Burnette set a witness MC post and marked new BTs: a 5" Bw S05°30'E 42.0', a 16" Pw S20°00'W 20.0' and a 6" twin Bw East 36.3,' per notes on Page 18 of Old Fieldbook 29 in Oneida County survey records; all now obliterated.

In May 1975, Lester J. Scmit/RLS 1192 notes an iron pipe at this corner per Plat of Survey B-872 in Oneida County survey records. In February 1977, William E. Bandow/RLS 1182 notes an iron pipe at this corner per Plat of Survey B-618 in Oneida County survey records. In May 1980, Joseph C. Kirby/RLS 253 notes an iron pipe at this corner per Plat of Survey B-2729 in Oneida County survey records. In May 1992, William E. Bandow/RLS1182 notes a 1" dia. iron pipe at this corner per Plat of Survey C-902 in Oneida County survey records and in November 1993 he also noted a 3/4" dia. iron pipe at this corner per Plat of Survey B-2833 in Oneida County survey records. This recovery completed on September 27, 2001 and was directly witnessed by the assistance of adjacent resort owner James Forsyth, who was very pleased that the section line was finally determined to fix the location of the West boundary of his land parcel and at the George Lake shoreline.

Plan view map of monument location with bearing and distance ties to a minimum of four(4) described witness or reference monuments of concrete, natural stone, iron, live bearing trees or equivalent material. If applicable, also show a minimum of two(2) bearing and distance ties to any other monument found and not accepted; including the bearing and distance from the accepted monument.

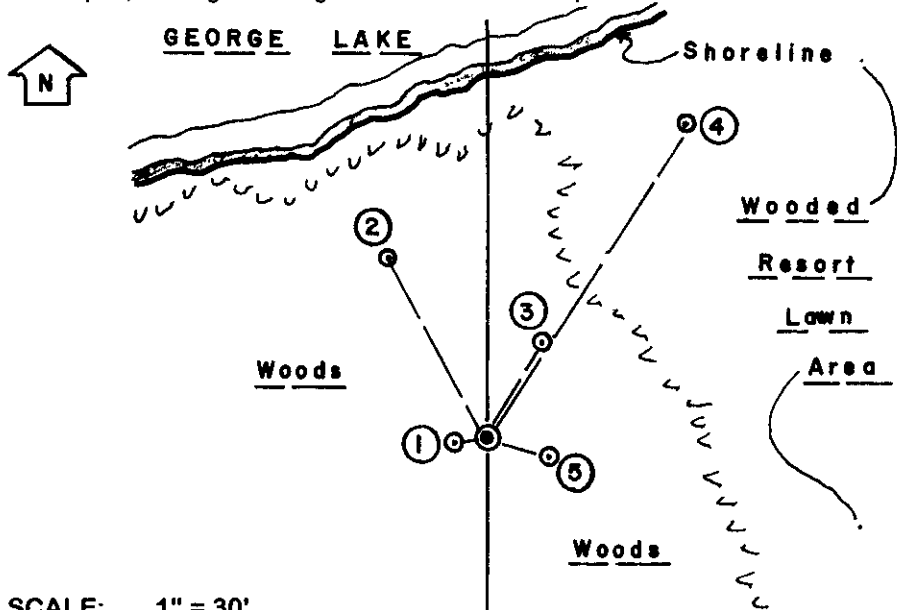

SCALE: 1" = 30'

Unless otherwise indicated, all bearing tree ties are to a .25" dia. by 2.5" long PK nail with a 1.25" dia. steel washer driven into unblazed right face and a .25" dia. by 2.5" long PK nail with a 2" dia. steel washer stamped BT is also driven into unblazed face of bearing tree at DBH; the basis for measured bearings is by compass to nearest degree and all tie distances are measured horizontal by steel tape corrected to nearest 1/100th feet at standard temperature of 68° F.

WITNESS MONUMENT TIES:

- ① New BT 5.5" Pw S80°W 5.00'.
- ② New BT 10" Pw N29°W 32.00'.
- ③ New BT 9" Pw N29°E 17.70'.
- ④ Old 1.25" dia. iron pipe with uncapped top flush with resort lawn area N31.5°E 58.55'.
- ⑤ New BT 6" Pw S73°E 9.80'.

Standard white poly 'T' corner marker post set along West side of corner monument.

Corner falls 58' South of existing shoreline of George Lake this date.

RLS SEAL:




LAND SURVEYOR CERTIFICATE:

I, William C. Rohde, hereby certify that I am duly licensed as a Professional Land Surveyor in the State of Wisconsin; that this USPLS monument location was determined by me and/or under my direct supervision and control; and that this U.S. Public Land Survey Monument Location Record is true and correct to the best of my knowledge and belief.

Signed *William C. Rohde*
William C. Rohde RLS 841

Date Signed: March 25, 2002

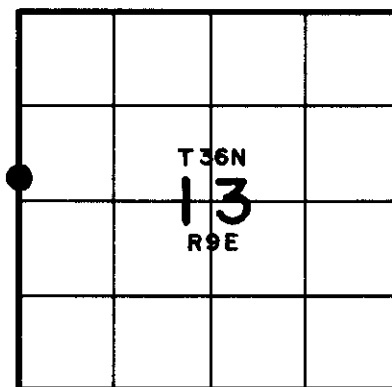

SECTION LOCATION MAP
INDEX NO. *R 9 E T 36 N S 13*