

U. S. PUBLIC LAND SURVEY MONUMENT RECORD


INSTRUCTIONS: This record shall show the location of the corner and shall include all of the following nine elements (a through i).

- (a) Identify the corner by reference to the U.S. public land survey system.
 ● = Corner monument restored.

The section corner common to sections 14, 15, 22 & 23, Town 36 North, Range 9 East, Oneida County, Wisconsin.

Compared with all record data and accepted as correct.

Robert H. Winat
 Robert H. Winat, Oneida Co. Surveyor
 4 May 1983

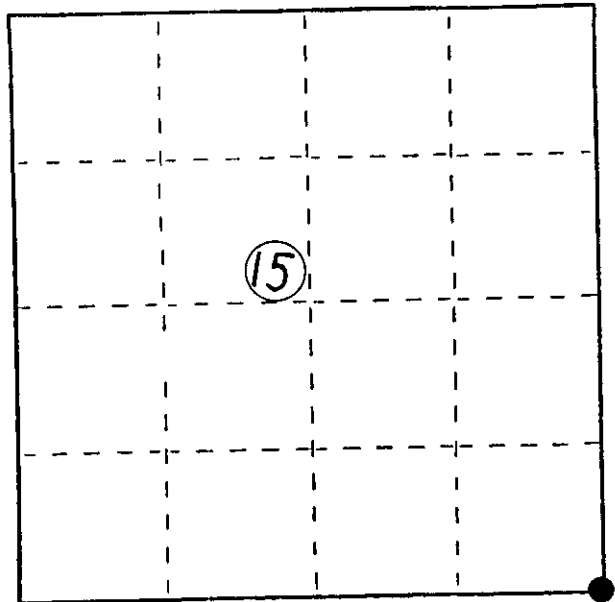


- (b) Describe any record evidence, monument evidence, occupational evidence, testimonial evidence or any other material evidence you considered, and whether the monument was found or placed.

Found 2" wall point at the south-west corner of the old school property.
 Old school fence bears north and east. See D. H. Vaughan's notes, 1909.

- (c) In the plan view drawing below, provide reference ties to at least 4 witness monuments, or, if the location is within a municipality, to at least 2 witness monuments. (Witness monuments shall be made of concrete, natural stone, iron or other equally durable material, except wood.) Describe witness monuments.

- (d) Show a plan view drawing depicting the relevant monuments and reference ties which is sufficient in detail to enable accurate relocation of the corner monument if the corner monument is disturbed. Indicate north.

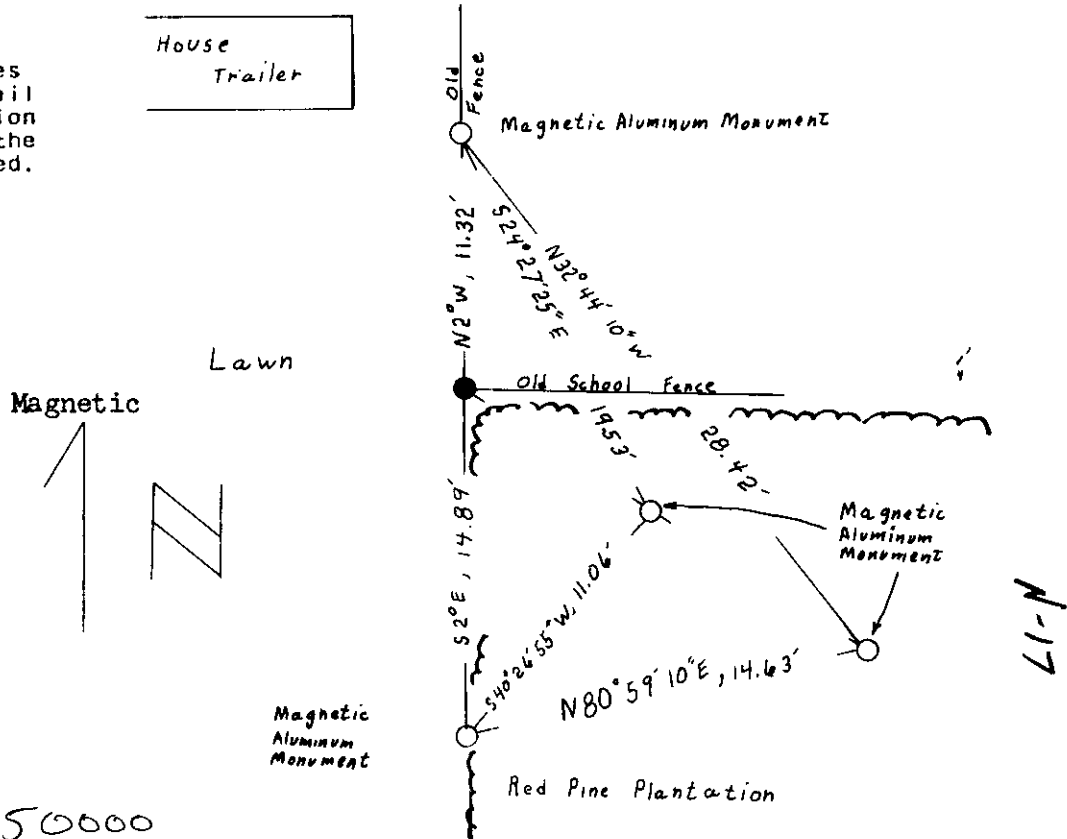

3609150000

(e) Describe any material discrepancy between the location of the corner as restored or reestablished and the location of that corner as previously restored or reestablished by distance and direction. Show the discrepancy on the plan view drawing under (d), above. Show the distances between the corner as previously restored or reestablished and (1) the corner as restored or reestablished, and (2) to at least 2 of the witness monuments shown on the drawing in (d), above.

NA - can't make ties as corner is covered.

C.S.M # 62 by Herbert Moore in June 1971 shows a 2" iron pipe S 1°36'E, 21.00 feet from the existing "school" fence. This monument is presently under a pile of concrete rubble and unaccessible. This monument does not fit any evidence as numerous references call for the S.W. corner of the "school" grounds as the section corner.

(f) Was the corner restored through acceptance of (1) an obliterated evidence location, or, (2) a found perpetuated location?

This corner was restored by acceptance of a found perpetuated location.
Refer: Vol. 196, Pg. 383-386, Register of Deeds records, for descriptions.


(g&h) Was the corner reestablished through lost corner proportionate methods? If so, show the method, including the directions and distances to other public land survey corners used as evidence or used for proportioning in determining the corner location?

NA

REGISTER'S OFFICE }
Oneida County, Wis. }

Received for Record the 28 day of
July A.D. 1983 at
2:20 o'clock P. M. and recorded in
Vol. 1 on page 1

Doris Verage Neuman
Register
Cynthia A. Fitts
Deputy

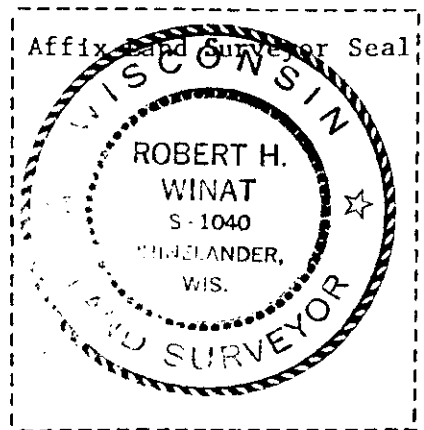

(i) I, Robert H. Winat, S-1040,
(type or print name) certify that the corner location shown on this record was determined by me or under my direction and control and that this U.S. Public Land Survey Monument Record is correct and complete to the best of my knowledge and belief.

Robert H. Winat Signature Date 29 April 1983