

This form is intended to fulfill requirements of Chapter A-E 7.08 (3)(a) thru (i) U.S. Public Land Survey Monument Location Record, Wisconsin Administrative Code. Use reverse side for geodetic location data and/or other continuation purposes.

# U.S. PUBLIC LAND SURVEY MONUMENT LOCATION RECORD

Recorders Data

USPLS CORNER: NORTH 1/4 SECTION: 22 TOWNSHIP: 36 NORTH RANGE: 9 EAST

NAME OF WATERWAY FOR M.C. CORNER: N/A SECTION LINE: N/A

(CITY)(VILLAGE)(TOWN) OF: PELICAN COUNTY OF: ONEIDA

Description of monument found or placed and all other evidence used as the basis for monument location; including monuments and related measurements required if the corner location was reestablished by lost corner proportionate methods. Also indicate name of original surveyor, original survey date and the corner monument, bearing trees, witness or other reference monuments established; including measured bearing and distance ties, from available records.

Found and accepted center of a hex head bolt flush with existing blacktop roadway surface; I drove head of bolt below road surface to deter disturbance by future road plowing.

In 1865, William E. Daugherty/GLO set a wood post as the original corner and marked OBTs, a 14" Py N87.5°E 10.59 and a 14" Py S83.25°E 10.20, all of which are now obliterated.

In 1980, James Kasson, RLS 1416, notes a nail in blacktop roadway at this corner and new BTs, a 12" Pj N08°E 56.0' and a 12" Pj S20°E 37.6', per his Plat of Survey filed as L-161 in Oneida County survey records.


In 1982 and 1984, Sy Poskie, RLS 140, notes a PK nail in center of blacktop roadway at this corner location per his Plats of Survey filed as B-108, B-110, B-1894 and B-1896 in Oneida County survey records.

In 1986, Todd Loftus, RLS 1523, notes a PK nail at this corner location per his Plat of Survey filed as B-3593 in Oneida County survey records.

In 1995, William Badow, RLS 1182, notes a bolt at this corner location in center of blacktop roadway per his Plat of Survey C-1219 filed in Oneida County survey records.

This recovery completed April 28, 1999; there were no direct witnesses other than vehicle drive-bys.

Plan view map of monument location with bearing and distance ties to a minimum of four(4) described witness or reference monuments of concrete, natural stone, iron, live bearing trees or equivalent material. If applicable, also show a minimum of two(2) bearing and distance ties to any other monument found and not accepted; including the bearing and distance from the accepted monument.

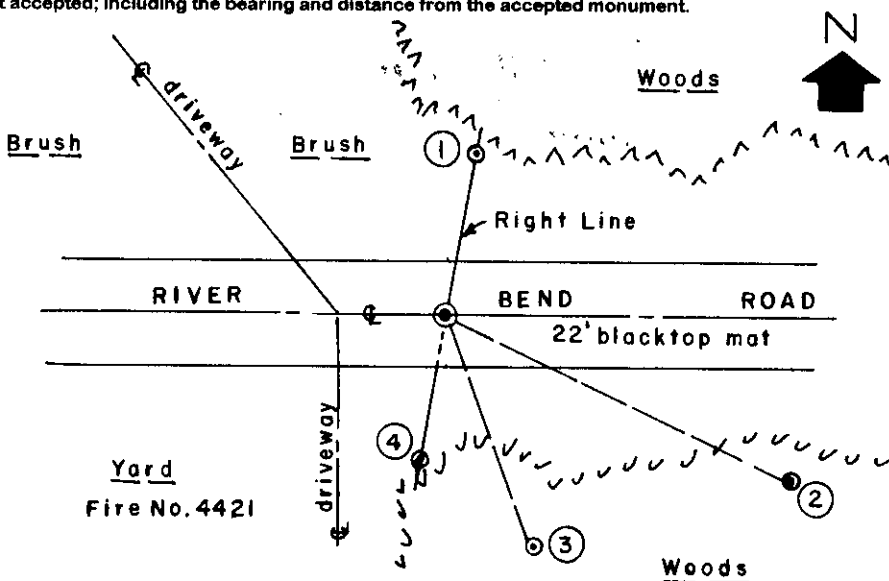

**WITNESS MONUMENT TIES:**

- ① Older 1" dia. iron pipe found in top of which I set a standard yellow poly Reference Mark cap flush with grade N10°E 33.25'.
- ② New BT 15" Pr S64°E 79.55'.
- ③ New BT 26" Pw S20°E 52.23'.
- ④ Set a 3/4" dia. by 24" long iron pipe with standard yellow poly Reference Mark cap flush with grade S10°W 31.80'.


Standard white poly 'T' marker post set 22' South of corner.

No witnesses other than drive-bys.

SCALE: 1" = 40'

Unless otherwise indicated, all bearing tree ties are to a .25" dia. by 2.5" long PK nail with a 1.25" dia. steel washer driven into unblazed right face and a .25" dia. by 2.5" long PK nail is also driven into unblazed face of bearing tree at DBH; the basis for measured bearings is by magnetic compass to nearest degree and all tie distances are measured horizontal by steel tape corrected to nearest 1/100th feet at standard temperature of 68 degrees Fahrenheit.

RLS SEAL:

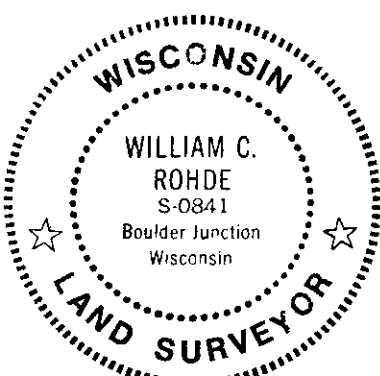


**LAND SURVEYOR CERTIFICATE:**

I, William C. Rohde, hereby certify that I am duly licensed as a Professional Land Surveyor in the State of Wisconsin; that this USPLS monument location was determined by me and/or under my direct supervision and control; and that this U.S. Public Land Survey Monument Location Record is true and correct to the best of my knowledge and belief.

Signed: *William C. Rohde*  
 William C. Rohde RLS 841

Date Signed: May 8, 1999

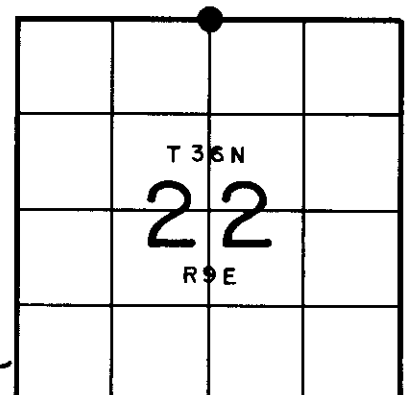

SECTION LOCATION MAP  
 INDEX NO. N 15  
 3609 150020