


U.S. PUBLIC LAND SURVEY MONUMENT RECORD

Note: This form is intended and designed to fulfill all requirements of Wisconsin Administrative Code, Chapter A-E 7.08 U.S. Public Land Survey Monument Record (3) (a) (b) (c) (d) (e) (f) (g) (h) (i). An additional sheet may be added if necessary to conform with said requirements.

(a) Corner location: Township 36 North
 Range 9 East/West

Town/City/Village PELICAN

County ONEIDA

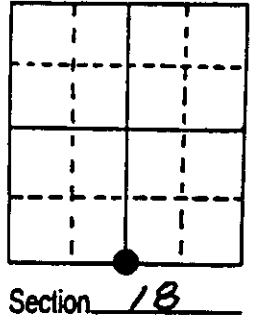

(b) (f) (g) (h) Description of monument found at this corner and if it was accepted, state all evidence (material, testimonial, occupational, plats, records, other monuments) used as a basis for accepting. If not accepted or if nothing was found, state evidence used as basis for establishing location. If reestablished through lost corner proportionate methods, indicate all monuments, distances and directions used to establish. Indicate type of monument found or set and sign post.



1863 - Wm. E. DAIGHERLY ESTABLISHED ORIGINAL 1/4 CORNER; BT'S: 6" ASPEN, S59°E, 61ks.
 do, N42°W, 71ks.

1894 - B. F. DORR RECOVERED CORNER & MADE NEW BT'S: 3" ASPEN, N80°E, 47 3/4 kS.
 6" R. OAK, S4 1/2°W, 52 1/2"

1953 - F. R. WINCENTSEN, ONEIDA COUNTY SURVEYOR INDICATED FINDING DORR'S POST.


1990 - I FOUND 1/4" IRON PIPE AT INTERSECTION OF OLD FENCE LINE RUNNING SOUTH & EAST. 60 FEET OF FENCE SOUTH OF IRON PIPE IS DOWN DUE TO GAS PIPELINE CONSTRUCTION. FENCE LINE RUNNING EAST IS DOWN BUT IS STILL EVIDENT. ALSO FOUND OLD SCRIBE IN 24" WHITE PINE BASE, BUT IT HAS NO RECORD. I REPLACED IRON PIPE WITH 3" ALUMINUM ONEIDA COUNTY MONUMENT & MADE 3 NEW BT'S.

(c) (d) (e) Plan view of corner with ties to at least 4 witness monuments. If in disagreement with previously established corner, show the distances between the two corners and also indicate the ties to the disputed corner.

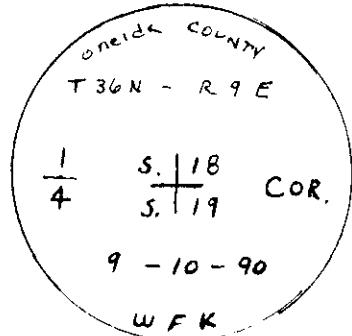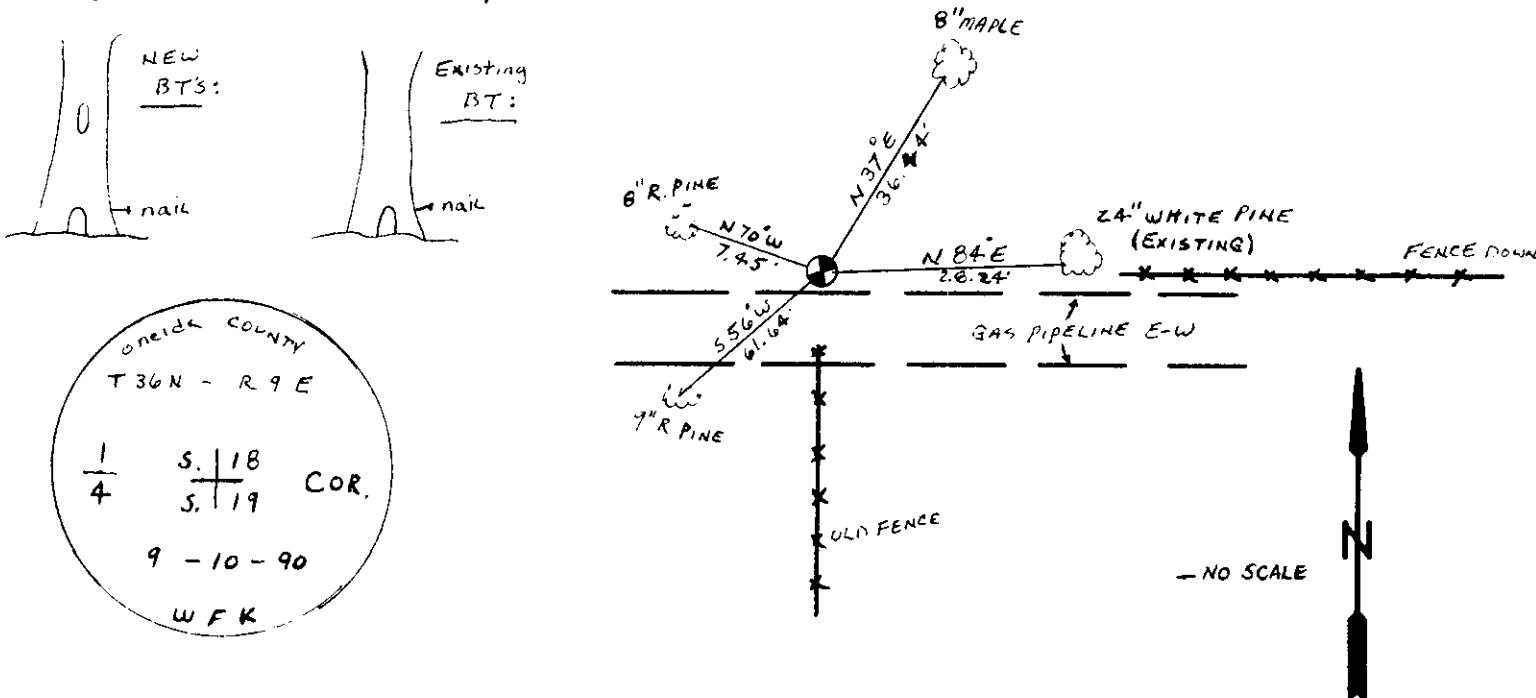

(i) WILLIAM F. KELLY
 (type or print name) certify that the corner location on this record was determined by me or under my direction and control and that this U.S. Public Land Survey Monument Record is correct and complete to the best of my knowledge and belief.

William F. Kelly 10-30-90
 Signature Date

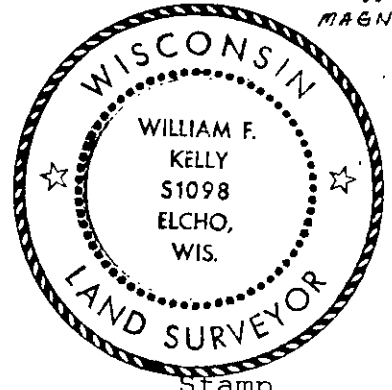

Index No. N-3

3609180020

U.S. PUBLIC LAND SURVEY MONUMENT RECORD

Note: This form is intended an designed to fulfill all requirements of Wisconsin Administrative Code. Chapter A-E 7.08 U.S. Public Land Survey Monument Record (3)(a)(b)(c)(d)(e)(f)(g)(h)(i). An additional sheet may be added to if necessary to conform with said requirements.

(a) Corner Location: Township 36 North
Range 9 East

Town of Pelican


Oneida County, Wisconsin

Oneida County Coordinate System NAD83(2011)
N 150915.047
E 262271.676

REGISTER OF DEEDS OFFICE
ONEIDA COUNTY
FILED

MAY 29 2018

KYLE J. FRANSON
REGISTER OF DEEDS

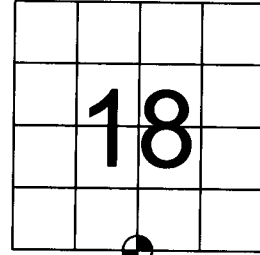

Section 18

(b)(f)(g)(h) Description of monument found at this corner and if it was accepted, state all evidence (material, testimonial, occupational, plats, records, other monuments) used as a basis for accepting. If not accepted or if nothing was found, state evidence used as basis for establishing location. If reestablishment through lost corner proportionate methods, indicate all monuments, distances and directions used to establish. Indicate type of monument found or set and sign post.

1863 WM. E. Daugherty established Original 1/4 corner and noted OBT's: 6" Aspen S59°E 6 links, 6" Aspen N42°W 7 links; all now obliterated beyond recovery purposes.

1894 B.F. Dorr Recovered corner and noted new BT's: 3" Aspen N80°E 47-3/4 links, 6" R. Oak S4-1/2°W 52-1/2 links; all now obliterated beyond recovery purposes.

1953 F.R. Wincentzen, Oneida County Surveyor indicated finding Dorr's post.



1990 William F. Kelly found 1-1/4" Iron Pipe at intersection of old fence line running south and east. 60 feet of fence south of iron pipe he noted was down due to gas pipeline construction. Fence line running east was down but still evident. He also found an old scribe in a 24" white pine base however it was not on record. He replaced the Iron pipe with a 3" Oneida County Monument and noted new BT's: 8" Maple N37°E 36.44', 24" White Pine N84°E 28.24', 9" Red pine S56°W 61.64' and a 8" Red Pine N70°W 7.45'. All with blazes and nails

2004 Russell F. Brown found Oneida County Monument as shown on Oneida County Survey Map C2111

October, 2017 I found and accepted 2" x 30" aluminum pipe with stamped 3" Aluminum Oneida County Monument cap. Found 3 of William F. Kelley's BT's and Set 3 new BT's as shown below.

(c)(d)(e) Plan view of corner with ties to at least 4 witness monuments. If in disagreement with previously established corner, show the distances between the two corners and also indicate the ties to the disputed corner.

Line Table			
Line #	Direction	Length	Discription
L1	N37°E	36.44'	FOUND NAIL IN 10" MAPLE W/ BLAZE
L2	N84°E	28.24'	FOUND NAIL IN 32" WHITE PINE W/ BLAZE
L3	S34°E	67.90'	SET NAIL IN 12" MAPLE AND BLAZED
L4	S56°E	61.64'	FOUND NAIL IN 18" RED PINE W/ BLAZE
L5	N46°W	57.15'	SET NAIL IN 12" MAPLE AND BLAZED

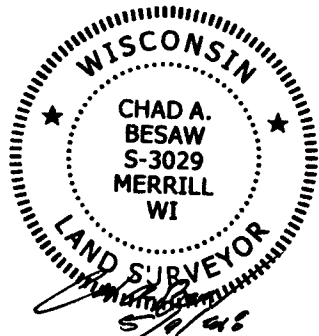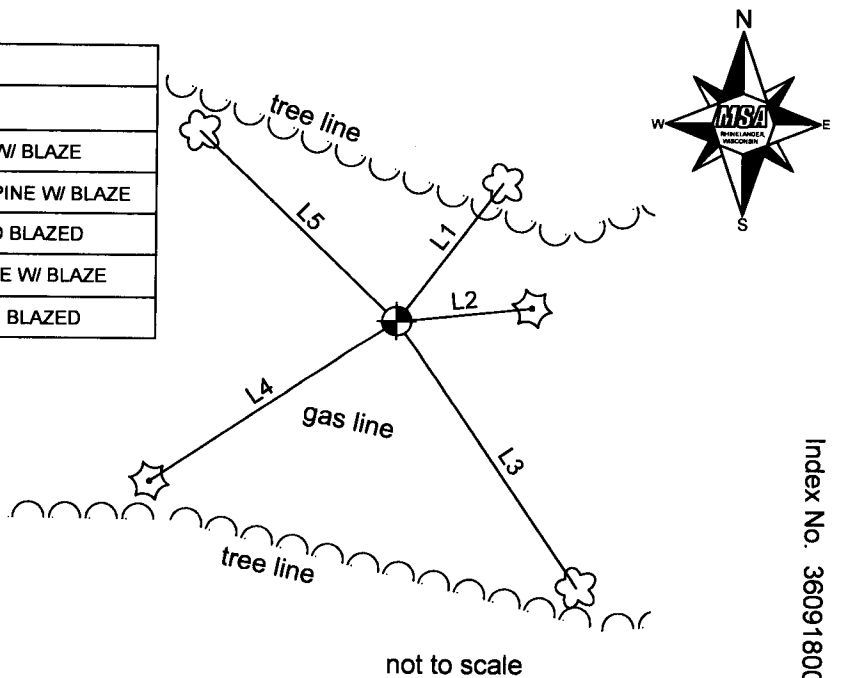

Index No. 3609180020

(i) I, Chad Besaw, Professional Land Surveyor PLS-3029, hereby certify that the corner location on this record was determined by me or under my direction and control and that this U.S. Public Land Survey Monument Record is correct and complete to the best of my knowledge and belief.

Chad Besaw
Signature

5/29/2018
Date