U.S. PUBLIC LAND SURVEY MONUMENT RECORD

Note: This form is intended and designed to fulfill all requirements of Wisconsin Administrative Code, Chapter A-E 5.02, U.S. Public Land Survey Monument Record (3) (a) (b) (c) (d) (e) (f) (g) (h) (i). An additional sheet may be added if necessary to conform with said requirements.

(a) Corner location: Township 36 North

Range 9 East[redacted]

Town/City/Village Pelican

County Oneida

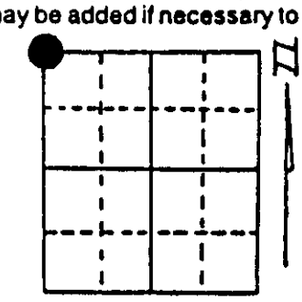

Section 29

(b) (f) (g) (h) Description of monument found at this corner and if it was accepted, state all evidence (material, testimonial, occupational, plats, records, other monuments) used as a basis for accepting. If not accepted or if nothing was found, state evidence used as basis for establishing location. If reestablished through lost corner proportionate methods, indicate all monuments, distances and directions used to establish.

-1863 Daugherty set corner Post Birch 10 S 4 E 85 lks, Birch 10 N 2 W 714 lks.
-1894 Dorr found NW corner Section 29 Y. Pine stake with stones around it.
-1901 Vaughan was at corner.
-1953 F.R. Wincentsen iron pin in center of intersecting roads.
-1988 W. E. Bandow found axle shaft and set NW corner 33' N in intersection of Town Roads. Referenced as shown below. Survey marker Post set 33' South alongside axle shaft.

(c) (d) (e) Plan view of corner with ties to at least 4 witness monuments. If in disagreement with previously established corner, show the distances between the two corners and also indicate the ties to the disputed corner.

— MAGNETIC BEARINGS TAKEN WITH HANDHELD COMPASS

— DISTANCES MEASURED TO 6" SPIKE

— NO SCALE

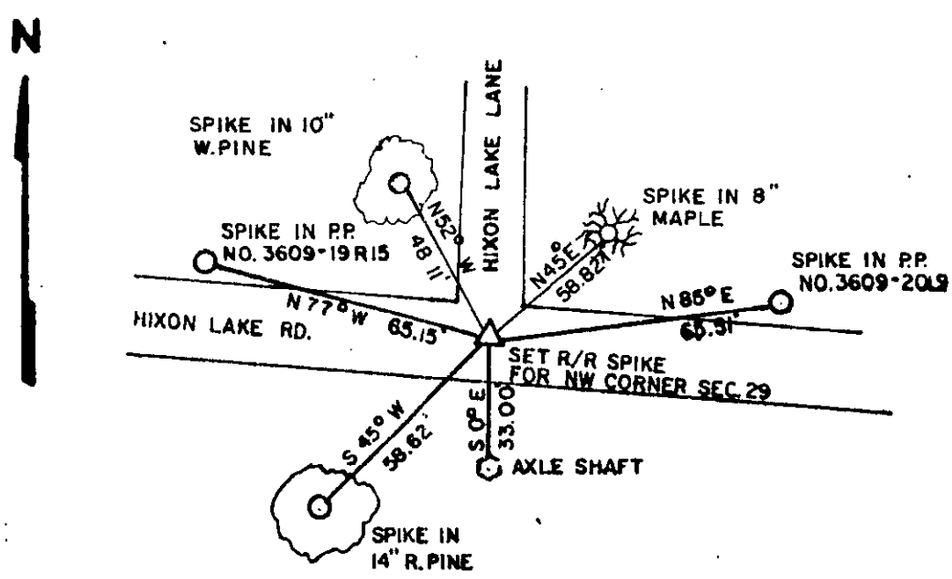

(i) I, William E. Bandow (type or print name) certify that the corner location on this record was determined by me or under my direction and control and that this U.S. Public Land Survey Monument Record is correct and complete to the best of my knowledge and belief.

William E. Bandow 11-3-88

Signature Date

WISCONSIN WILLIAM E. BANDOW S-1182 RHINELANDER WIS. LAND SURVEYOR

Index No. R-5

3609190000