

CERTIFIED LAND CORNER RESTORATION

Index No. R-9

State of Wisconsin

County of Oneida } ss.

I Milo E. Stefan, do hereby certify that on the 25th day of June, 19 82, I found evidence of the southwest corner of section 21 Township 36, North, Range 9, East, Fourth Principal Meridian, as described hereon; and that from this evidence I established a new monument and accessories as described hereon to perpetuate the original location of this corner.

Resident witnesses:

History of original corner establishment: Original survey by William E. Daugherty in July and August of 1863.



Dorr in July of 1894 restored this corner from the original BT's and placed a new post and two new BT's: 6" spruce, S22 1/2°E, 11 1/2 links, (7.59 feet) 5" spruce, N45°W, t 3/4 links (4.46 feet)

Description of corner evidence found:

- 1) 3" x 3" x 5' cedar post in fence line
2) Scribing in spruce stump, S22 1/2°E, 7.59 feet (Dorr's BT of 1894)
3) Stump remains N45°W, t.46 feet
4) New BT of unknown source, 6" cedar, S9°W, 23.53 feet

Description of monument and accessories I established to perpetuate the original location of this corner: I placed an aluminum monument 2" x 72" long with an Oneida County Tablet embossed and stamped as follows:

- I made the following new bearing trees: 1) 12" black ash, N75°E, 30.00 feet 2) 6" black ash, S39°E, 22.75 feet 3) 10" tamarack, N30°W, 33.65 feet 4) 6" cedar, S9°W, 23.53 feet 5) 3" x 3" x 5' cedar post S43°W, 2.6 feet

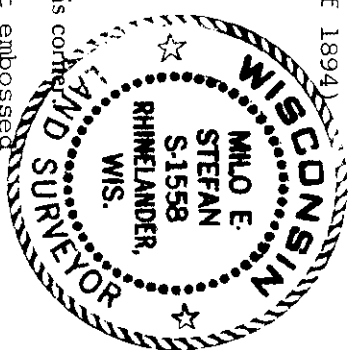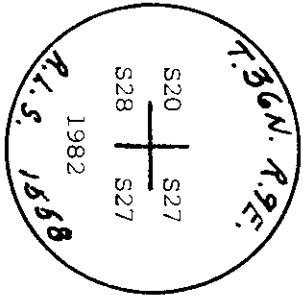

Dated at Rhinelander, Wis., this 21st day of January, 19 83.

Signature Milo E. Stefan Title Land Surveyor (County Surveyor, Registered Land Surveyor, or other duly authorized official) Registration No. S-1558

Office of Register of Deeds, County of Oneida. I hereby certify that the within instrument was filed in this office for record on the 11th day of June, 1984, at 4:00 o'clock P.M.

By Donna Denny, Register of Deeds, Deputy

3609200000

