U.S. PUBLIC LAND SURVEY MONUMENT RECORD

Note: This form is intended and designed to fulfill all requirements of Wisconsin Administrative Code, Chapter A-E 5.02, U.S. Public Land Survey Monument Record (3) (a) (b) (c) (d) (e) (f) (g) (h) (i). An additional sheet may be added if necessary to conform with said requirements.

(a) Corner location: Township 36 North

Range 9 East [redacted]

Town/City/Village Pelican

County Oneida

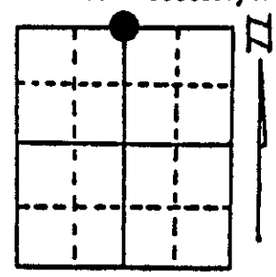

Section 29

(b) (f) (g) (h) Description of monument found at this corner and if it was accepted, state all evidence (material, testimonial, occupational, plats, records, other monuments) used as a basis for accepting. If not accepted or if nothing was found, state evidence used as basis for establishing location. If reestablished through lost corner proportionate methods, indicate all monuments, distances and directions used to establish.

-1863 W. E. Daugherty set N 1/4 Post of Section 29 Birch 12 N 88 E 1146 Birch 10 S 43 W 482.
-1894 Dorr found corner in place.
-1901 Vaughan found corner in place.
-1988 W. E. Bandow set corner as referenced below. Set survey marker Post N 20' ±.

(c) (d) (e) Plan view of corner with ties to at least 4 witness monuments. If in disagreement with previously established corner, show the distances between the two corners and also indicate the ties to the disputed corner.

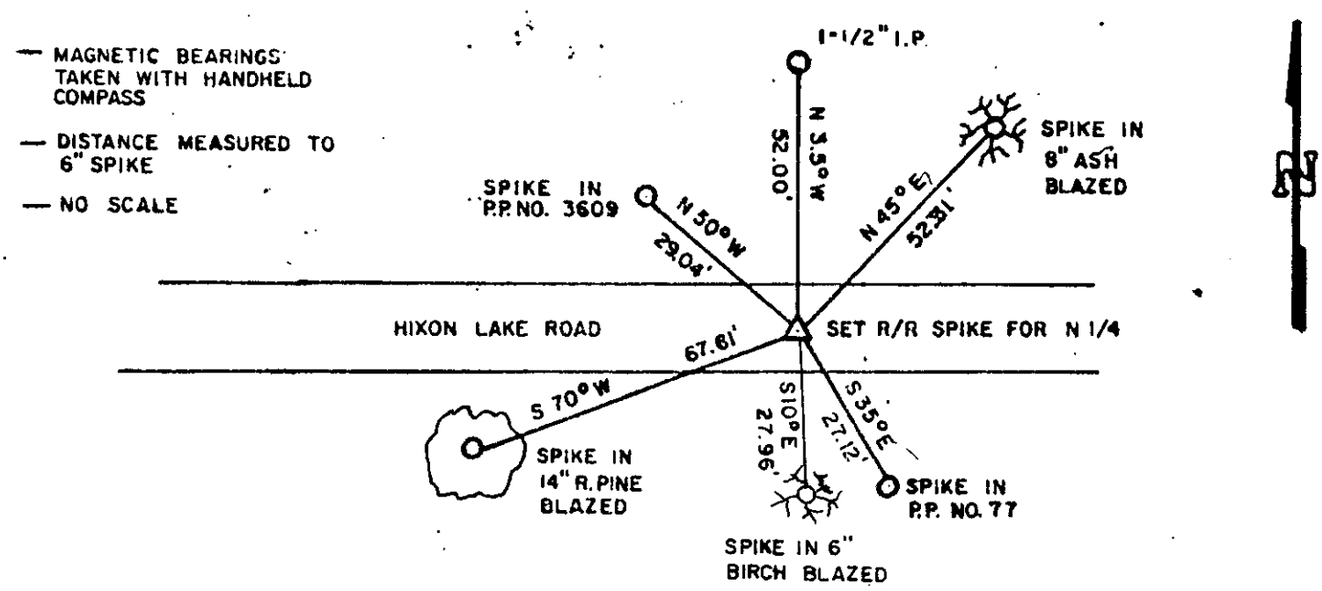

(i) I, William E. Bandow (type or print name) certify that the corner location on this record was determined by me or under my direction and control and that this U.S. Public Land Survey Monument Record is correct and complete to the best of my knowledge and belief.

William E. Bandow 11-3-88

Signature Date

WISCONSIN WILLIAM E. BANDOW S-1182 RHINELANDER WIS. LAND SURVEYOR

Index No. R-1

3609200020