


CERTIFIED LAND CORNER RESTORATION

Index No. **R-13**

State of Wisconsin } ss.
 County of Oneida }

I Philip T. Hansen do hereby certify that on the 13th day of April, 1976, I found evidence of the Section corner of 21 - 22 - 27 - 28 Township 36 North, Range 9 East, Fourth Principal Meridian, as described hereon; and that from this evidence I established a new monument and accessories as described hereon to perpetuate the original location of this corner.


Resident witnesses:
 Glen Barker
 Jim Claflin
 Herb Wagoner

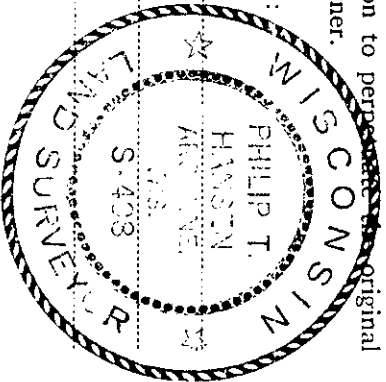

History of original corner establishment: Original Corner established by Wm. E. Dougherty, Deputy Surveyor, in 1863, from which Hemlock 24" bears N 30° W 47 lks, Birch 7" bears S 23° W 55 lks. Corner recovered and restored by B.F. Dorr, County Surveyor. Corner recovered by Ripco Surveyors, Goddard and crew, in 1961. Set 2" iron pipe with aluminum cap. Marked NBTs - Red Pine 16" S 3° W 69 lks, Red Pine 6" S 84° W 62 lks.

Description of corner evidence found: Recovered 2" iron pipe with aluminum cap stamped. Monument projects 18" above ground. Recovered UBT - Red Pine 16" (20") S 3° W 69 lks, scribed S 28 T36N R 9E 21 | 22 28 | 27
 Red Pine 6" (12") S 84° E (S 80° E) 62 lks, scribing
 Corner recovered in perfect condition. RIPC

Description of monument and accessories I established to perpetuate the original location of this corner. AS monument was in perfect condition, it was left in place. Marked NBT. Red Pine 10" N 39° E 43.0 lks, scribed S 6 BT. Distances measured to center of BTs.

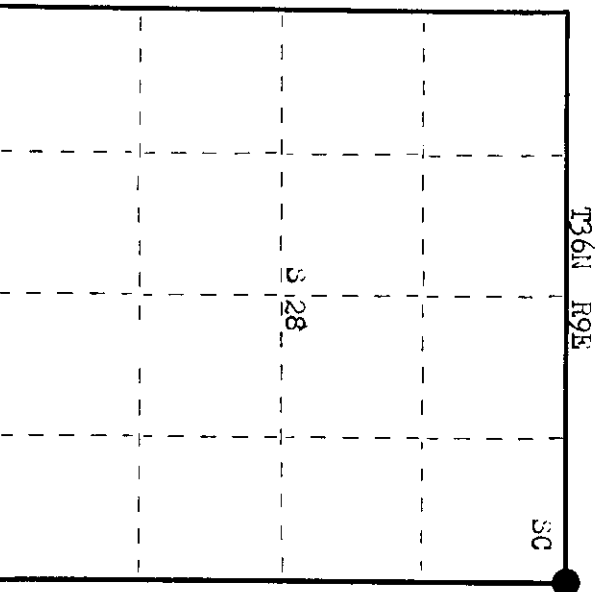

Dated at Oneida, Wis. this 22nd day of July, 1976

Signature: *Philip T. Hansen* Title: Registered Land Surveyor Registration No. 5-498
 (County Surveyor, Registered Land Surveyor, or other duly authorized official)
 Office of Register of Deeds, County of Oneida. 3rd day of August, 1976
 at 10:30 o'clock A.M. I hereby certify that the within instrument was filed in this office for record on the 3rd day of August, 1976

Signature: *Bone LePage*
 (Register of Deeds)

By: Deputy 3609210000