U.S. PUBLIC LAND SURVEY MONUMENT RECORD

Note: This form is intended and designed to fulfill all requirements of Wisconsin Administrative Code, Chapter A-E 7.08 U.S Public Land Survey Monument Record (3) (a) (b) (c) (d) (e) (f) (g) (h) (i). An additional sheet may be added if necessary to conform with said requirements.

(a) Corner location: Township 36 North

Range 9 East/~~West~~

Town/~~City/Village~~ Pelican

County Oneida

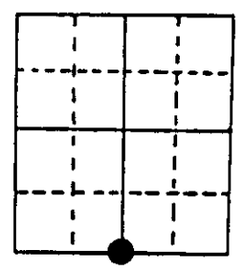

Section 21

(b) (f) (g) (h) Description of monument found at this corner and if it was accepted, state all evidence (material, testimonial, occupational, plats, records, other monuments) used as a basis for accepting. If not accepted or if nothing was found, state evidence used as basis for establishing location. If reestablished through lost corner proportionate methods, indicate all monuments, distances and directions used to establish. Indicate type of monument found or set and sign post.

1863 - Wm. Daugherty established this corner and set wood post.

1894 - Dorr restored corner from original evidence.

1961 - RIPCO recovered Dorrs corner in subdivision of Section 21. They set a 1 1/2" iron pipe with aluminum tablet/two BTs:
8" Tamarack, N51°E, 52.44 Feet 10" Aspen, S28°W, 28.77 Feet

1982 - Milo E. Stefan located RIPCO cap and Tamarack BT - Aspen down and rotted. Location Poster on fence post, S28°W, 19.0 Feet.

12/5/1990 - Certificate prepared in 1982 has been misplaced and at the request of the county, I revisited the corner and found the monument and Tamarack BT in good condition. I made two new BTs and placed a plastic sign post.

(c) (d) (e) Plan view of corner with ties to at least 4 witness monuments. If in disagreement with previously established corner, show the distances between the two corners and also indicate the ties to the disputed corner.

1) 1 1/2" iron pipe with aluminum tablet (RIPCO)
2) 8" Tamarack, N51°E, 52.44 Feet
3) Fence Post with Location Poster, S28°W, 19.0 Feet
4) 10" Red Pine, S55°W, 76.31 Feet
5) 6" Red Pine, N87°W, 69.47 Feet
6) Plastic Sign Post, East, .4 Feet

Distances to nail in side of BTs.
Stump blaze scribed "BT".

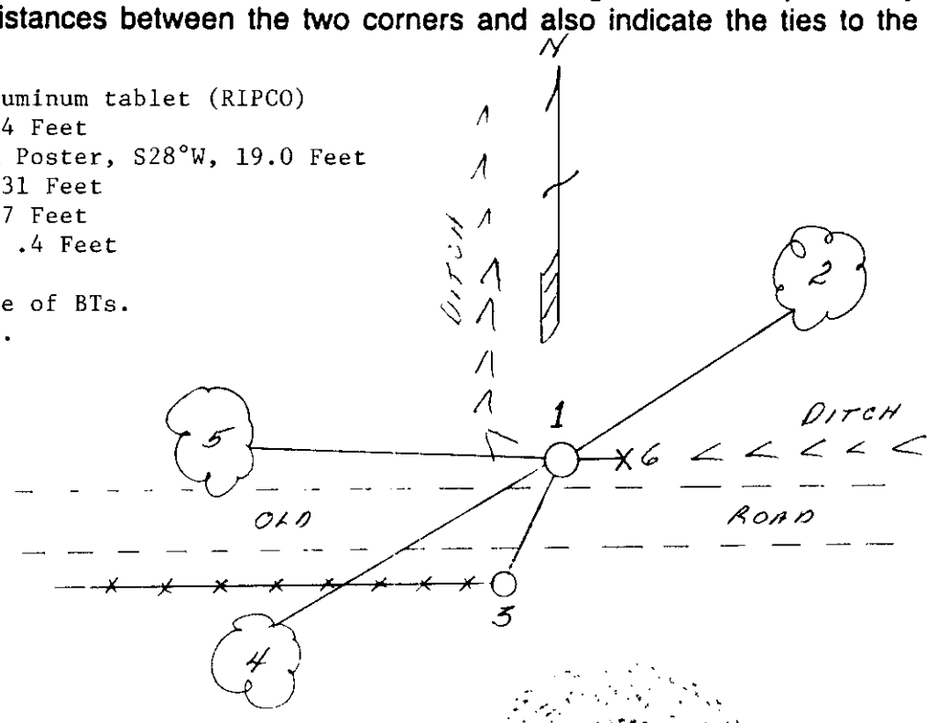

REGISTER OF DEEDS OFFICE
ONEIDA COUNTY, WIS.
FILED
DEC 12 1990
At _____ O'Clock _____ M
THOMAS H. LEIGHTON
REGISTER OF DEEDS

(i) I, Milo E. Stefan (type or print name) certify that the corner location on this record was determined by me or under my direction and control and that this U.S. Public Land Survey Monument Record is correct and complete to the best of my knowledge and belief.

Milo E. Stefan 12/5/90

Signature Date

3609210020

Stamp

Index No. R-11