

CERTIFIED LAND CORNER RESTORATION



Index No. **Q-11**

State of Wisconsin } ss.
 County of Oneida

I Philip T. Hansen do hereby certify that on the 9th day of April, 1976, I found evidence of the SC 1/16 corner of Section 21 Township 36 North, Range 9 East, Fourth Principal Meridian, as described hereon; and that from this evidence I established a new monument and accessories as described hereon to perpetuate the original location of this corner.

Resident witnesses:

Glen Barker
 Jim Claflin
 Herb Wagoner

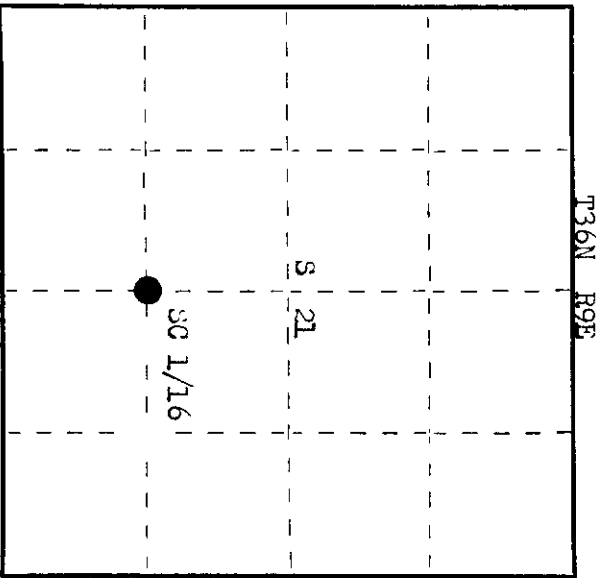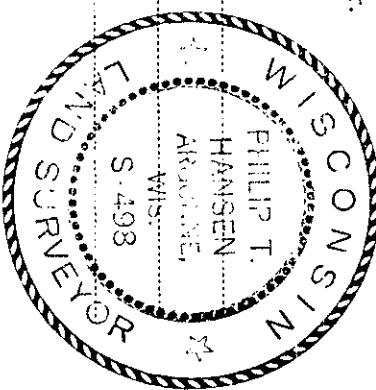

○ = Corner monument restored.

History of original corner establishment: Corner established by Kipco surveyors, Goodard and crew, in 1961. Ran random line bearing $358^{\circ} 20'$ mag. from recovered $1/4$ corner, 82.04 chains to point 1.04 chains east of $N 1/4$ corner. Established $C 1/4$ corner at 40.93 chains. Set $SC 1/16$ corner at 20.465 chains equidistant. Marked BTs - Basswood 14" $N 77^{\circ} W 1.32$ chs., Telephone pole $S 30^{\circ} W 75-3/4$ lks.

Description of corner evidence found: Recovered 1" iron pipe, the aluminum cap of which had been removed.
 Recovered OBT - Basswood 14" ($16"$) $N 77^{\circ} W 1.32$ chs., scribbing grown over.
 Telephone poles have been removed.

Description of monument and accessories I established to perpetuate the original location of this corner.
 Replaced iron pipe with $1\frac{1}{2}"$ OJ iron pipe with 2" brass cap stamped.
 Pipe projects 18" above ground.
 OBT - Red Pine 6" $N 24^{\circ} W 120.9$ lks, scribed 1/16 BT.
 Dist. measured to center of OBT & BT.

3498
 T36N R9E
 SC 1/16 S 21
 OPI - 1976

Dated at Oneida, Wis., this 19th day of July, 1976

Signature: *Philip T. Hansen* Title: Registered Land Surveyor Registration No. 3-498
 (County Surveyor, Registered Land Surveyor, or other duly authorized official)
 Office of Register of Deeds, County of Oneida
 Instrument was filed in this office for record on the 23rd day of July, 1976 at 1:00 o'clock P.M.
 I hereby certify that the within

Signature: *Loraine Terage-Huebner*
 (Register of Deeds)

By: Deputy

3609211020