

CERTIFIED LAND CORNER RESTORATION

Index No. **R11**

State of Wisconsin }  
 County of Oneida } ss.

I Philip T. Hansen, do hereby  
 certify that on the 9th day  
 of April, 1976, I found

evidence of the C 1/4  
 corner of Section 21

Township 36, North, Range  
 9 West, Fourth Principal Meridian,



as described hereon; and that from this evidence  
 I established a new monument and accessories  
 as described hereon to perpetuate the original  
 location of this corner.

Resident witnesses:

Glen Barker

Jim Clafflin

Herb Wagoner

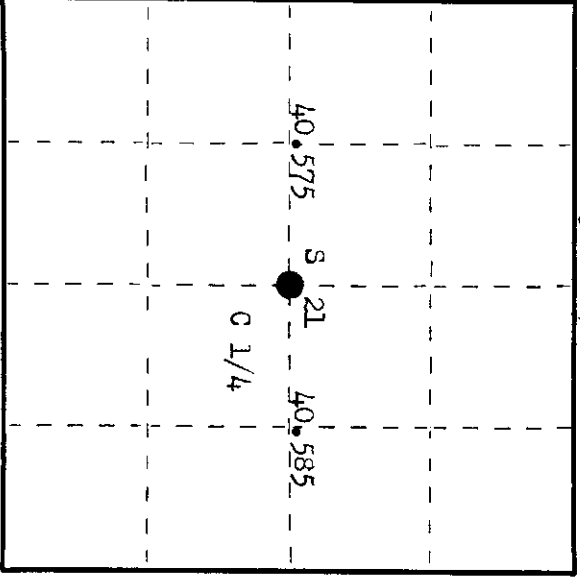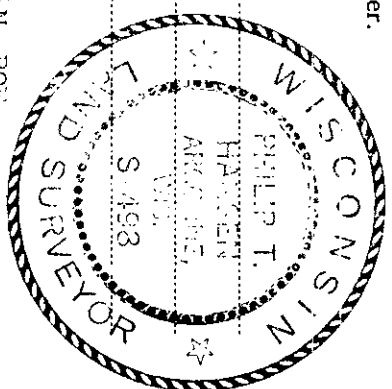

○ = Corner monument restored.

History of original corner establishment: Corner established by Ripco Surveyors, Goddard and crew, in 1961. ran E-W and N-S 1/4 lines iron re-established 1/4 corners. Set C 1/4 Corner 40.575 east of E 1/4 corner and 40.585 chains east of " 1/4. Marked NBTs - B. spruce 3" N 57° W, 1.275 chains. Pine, white 20" N 23° W 1.595 chains.

Description of corner evidence found: Recovered a RR spike in black top road. Spike was bent and found .2 lk out of position. Recovered witness corner, 2" iron pipe with aluminum cap 50 lks west, projecting 18" above ground. Cap stamped. Recovered NBTs - B. spruce 20" (22") N 23° W 1.595 chs. described C 1/4 S21. T36N R9E B. spruce 3" (10") N 57° W (N 50° W) 1.275 chs. described C 1/4 S21 BT. C 1/4 + S21 Cor. 50 lks W N1PCU

Description of monument and accessories I established to perpetuate the original location of this corner. Set a new RR spike in place of bent spike 2" below surface of blacktop. As witness corner was in excellent condition, we left it in place. Corner sets in intersection of N-S winquist road and River Bend Road. Witness monument and BTs painted blue.

Dated at Rhinelander, Wis., this 22nd day of July, 1976.

Signature: *Philip T. Hansen* Title: Registered Land Surveyor Registration No. 2498  
 County Surveyor, Registered Land Surveyor, or other duly authorized official

Office of Register of Deeds, County of Oneida. I hereby certify that the within instrument was filed in this office for record on the 3rd day of August, 1976 at 10:20 o'clock P.M.

*Louise Berge Kuehn*  
 (Register of Deeds)

By: \_\_\_\_\_ Deputy

3609212020